

INTERIOR RENOVATION  
FOR :  
ATLANTA FIRST UNITED METHODIST CHURCH  
360 PEACHTREE ST. NE  
ATLANTA, GA 30308

"AS BUILT"  
DRAWINGS



ARCHITECTURE  
ENGINEERING  
INTERIOR DESIGN  
CONSTRUCTION SERVICES

675 Tower Road, Marietta, Ga 30060-6958  
Off: 770.423.0016  
Fax: 770.424.0260  
www.cdhparkers.com

"AS BUILT"  
DRAWINGS

PROJECT NOTES

BUILDING AREA FLOOR	EXISTING	RENOVATED	NEW	TOTAL
LEVEL 100 FLOOR PLAN	13717 SF	000 SF	301 SF	14018 SF
LEVEL 200 FLOOR PLAN	20002 SF	757 SF	000 SF	20002 SF
LEVEL 300 FLOOR PLAN	16796 SF	000 SF	000 SF	16796 SF
TOTAL				50816 SF

CODE INFORMATION

- Atlanta First United Methodist Church  
360 Peachtree Street NE  
Atlanta, Georgia 30308

1. Building Usage: church

2. Building Area: no change in current status

3. Construction Classification: I.B.C.: V, unprotected, unsprinklered NFPA 101:

4. Occupancy Classification: I.B.C.: Assembly Group A-3 NFPA 101: Existing Assembly

1. Standard Parking:  
Required: no change in current status  
Actual: no change in current status

2. Handicap Parking:  
Required: no change in current status  
Actual: no change in current status
1. Scope of Work:  
to make changes necessary for installation of replacement organ, add an organ console lift, rebuild the chancel, add an accessible toilet.

2. Building Area by Floor:  
Level One:  
Level Two:  
Level Three:

1. SBCCI Standard Building Code (International Building Code), 2000 Edition, with Georgia Amendments
2. SBCCI Standard Building Code (International Building Code), 2000 Edition, with Georgia Amendments
3. SBCCI Standard Fire Prevention Code (International Fire Code), 2003 Edition, with Georgia Amendments
4. SBCCI Standard Mechanical Code (International Mechanical Code), 2000 Edition, with Georgia Amendments
5. SBCCI Standard Code (International Building Code), 2000 Edition, with Georgia Amendments
6. SBCCI Standard Plumbing Code (International Plumbing Code), 2000 Edition, with Georgia Amendments
7. National Electrical Code, 2005 Edition, with Georgia Amendments
8. Rules & Regulations Of The Safety Fire Commissioner, Chapter 120-3-3
9. American National Standards Institute (ANSI) A117.1 - 1986 Edition
10. Ga Accessibility Code, 1997 Edition, Chapter 120-3-20
11. CABO Model Energy Code, 1995 Edition, with Georgia Amendments
12. The American National Standard Safety Code for elevators, dumbwaiters, escalators, and moving walks ANSI A17.1-1984 Edition
- STRUCTURAL FIRE RESISTANCE REQUIREMENTS:
1. All existing structure is nonrated and existing to remain

GENERAL NOTES

- PERMITS AND LICENSE
1. The Contractor must have a current Business License and a Code Compliance Bond.
2. Subcontractors must have a current Business License.
3. Electrical, plumbing and heating subcontractors must get their work approved when obtaining permits.
4. The Contractor shall assure that final inspections are made on the building permit and on each subcontractor's permit, and that the final sign off card is signed by the inspector of each division.
5. Signs shall be permitted separately thru Planning and Zoning Department.
6. Construction trailers are to be permitted thru Planning and Zoning Department.
7. Land Disturbance Permit must be displayed on site at all times during construction and in plain view from a county road or street.

- UTILITIES
1. Locations of underground utilities are approximate. The General Contractor shall notify and request each to visit the site, locate and mark locations. During the course of construction, protect utilities from damage. Remove cap, or alter utilities only as prescribed by these documents or as directed in writing by the Architect or respective utility company.
2. Electrical, mechanical and outside utility work is to be coordinated so that there is a minimum of cutting and patching.

- DIMENSIONS
1. All interior dimensions shown on floor plans for metal stud partitions are to the face of stud, (unless center line is shown), or to the centerline of any column grid shown.
2. Contractor shall check and verify all dimensions and job conditions at the site, reporting all discrepancies between the job and drawings to the Architect.
3. All exterior dimensions shown on floor plans are to the face exterior walls or to the centerline of any column grid shown.
4. All site dimensions shown are to the face of curb or edge of pavement and to face of exterior walls.

- CONTRACT DOCUMENTS
1. The plans are complementary; therefore, the Contractor shall see mechanical, structural and electrical plans, and what is required by any one shall be binding as if required by all. The intention of the documents is to include all labor, materials, equipment and other items necessary for the proper execution and completion of the work. All Subcontractors will be responsible for knowledge
2. The written specifications, and any addenda for this project complement the drawings, and are hereby made a part these plans and shall be specifications for all materials used on this project.
3. All drawings and details incorporating existing conditions are representative of existing conditions only. The Contractor shall verify the accuracy of all details with actual conditions and coordinate with the Architect any deviations of the details to execute the intent of these details.
4. The Architect's approval of shop drawings or samples shall not relieve the Contractor of responsibility for any deviation from the Contract Documents, nor shall the Architect's approval relieve the Contractor from responsibility for errors or omissions in the shop drawings or samples.

- DRAWING KEYNOTE SYSTEM
- A keynoting system is used on the drawings for materials references and notes. For an index of each keynote that appears on a drawing, refer to the materials keying section in the upper right of the title block of each drawing. A master keynote list of all keynotes appearing in the architectural drawings can be found on sheet G001. Each keynote consists of a 5-digit number followed by an alphanumeric suffix. The 5-digit number relates to the specification section which generally covers the item that is referenced. The suffix is used to differentiate between the materials specified in each specification section. The suffix does not relate to any corresponding reference letter or number in the specification. The organization of the keynoting system on the drawings with the keynoting reference numbers related to the specifications sections numbering system shall not control the contractor in dividing the work among subcontractors or in establishing the extent of work to be performed by any trade.

- GENERAL NOTES
1. General Contractor is to comply with all local building codes and regulations which are presently in effect.
2. The Contractor shall visit the site, familiarize himself with the local conditions under which the work is to be performed, and correlate his observations with the requirements of the Contract Documents.
3. The General Contractor shall be responsible for coordination of all work concerning provisions for and installation of equipment noted NIC (not in contract).
4. All vertical mechanical chase walls shall extend from finish floor to structure above and have a two-hour Fire Rating.
5. All exposed mechanical units, ducts, and electrical panels shall be painted to match adjacent wall finish.
6. Furr in all fire extinguisher cabinets so as to afford proper recessed fit and to maintain the integrity of any rated wall in which they occur.
7. Furr in all mechanical ducts, pipes and vents in all areas: except gas pipes where required by code to be run exposed.
8. Where furring is not shown on plans, check and verify locations of ducts, pipes and vents with Mechanical Drawings and furr in same with material to match adjacent finishes.
9. All vertical ceiling drops shall be made of same material ascending in room in which drop occurs unless noted or detailed otherwise.
10. All ceiling heights shall be as indicated on plans unless mechanical, electrical or structural (new or existing) components prevent full height. In the event of a conflict, the Contractor shall notify the Architect. Ceiling will then be adjusted to as close as possible to the heights shown.
11. Where Finish Schedule shows existing finishes to remain, these shall be repaired and/or extended into renovated area.
12. Architect shall be notified immediately upon the discovery of any possible historic or anthropologic finds during construction.
13. Drywall partitions which extend to structure shall be tight against beams, headers, joists or decks and be caulked with sealant. At rated partitions, provide U.L.L. listed sealants.
14. All wood doors are to be sanded and sealed on top, bottom, sides, and edges
15. Provide double studs at all openings in walls.
16. Provide jamb anchor clips, floor anchor clips and mitered head splices at all door and borrowed light frames.
17. All wood blocking shall be fire retardant treated.
18. Sand concrete floors smooth prior to installation of vinyl composition floor tile. Clean all walls, door and window frames, ceilings, etc. from dust and dirt from sanding of floors prior to painting these areas.
19. All exposed electrical fixtures such as exit lights, fire alarms, wall or ceiling mounted clocks, etc. shall be centered on architectural features as indicated on reflected ceiling plans.
20. Corridor partitions, smoke stop partition, horizontal exit partitions, exit enclosures and other fire signs or stenciling 12" or less, max. in a manner acceptable to the authority having jurisdiction. Such identification shall be above any decorative ceiling and concealed spaces. Suggested wording - "FIRE AND SMOKE BARRIER - PROTECT ALL OPENINGS." Size of Lettering shall be 2" high.

DRAWING INDEX

COVER SHEET

T001 TITLE SHEET

CIVIL

NOT APPLICABLE

GENERAL INFORMATION

G101 GENERAL INFORMATION

DEMOLITION

D101 LEVEL 100 DEMOLITION PLAN  
D103 LEVEL 200 DEMOLITION PLAN  
D103 LEVEL 300 DEMOLITION PLAN  
D251 DEMOLITION SECTIONS

ARCHITECTURAL

A021 PARTITION TYPES AND DOOR SCHEDULES / DOOR ELEVATIONS  
AC01 ARCHITECTURAL COMPOSITE AND TOILET PLANS  
A101 PARTIAL FLOOR PLAN : LEVEL 100  
A102 PARTIAL FLOOR PLAN : LEVEL 100  
A103 PARTIAL FLOOR PLAN : LEVEL 300  
A151 ROOF PLANS  
A251 BUILDING SECTIONS  
A401 REFLECTED CEILING PLAN: LEVEL 100  
A402 REFLECTED CEILING PLAN: LEVEL 200  
A403 REFLECTED CEILING PLAN: LEVEL 300  
A501 WALL SECTIONS  
A502 HANDICAP LIFT DETAILS  
A503 WALL SECTIONS / DETAILS

KEYNOTES

A Keynote System is used on these Drawings for material references and notes. Refer to the Keynote Legend on the Drawing for the information which refers to each Keynote Symbol on that respective Drawing.

Each Keynote Symbol consists of a 5-digit number followed by an alpha numeric suffix. The 5-digit number relates to a Specification Section which generally covers the item that is referenced. The alpha numeric suffix combined with the 5-digit number creates a Keynote Symbol which identifies the specific reference notation used on the Drawing. The suffix does not relate to any corresponding reference letter or number used in the organization system of the Specifications

The use of Keynote Reference Numbers on these Drawings is a convention only for denoting materials used and incorporated into the Drawings. These numbers shall not control the Contractor in dividing the Work among his Sub-Contractor or in establishing the extent of work to be performed by any trade.

STRUCTURAL

S100 FOUNDATION AND FRAMING PLANS  
S200 SECTIONS AND DETAILS

MECHANICAL

M101 HVAC  
M102 HVAC  
M103 HVAC


PLUMBING AND FIRE PROTECTION

P102 PLUMBING

ELECTRICAL

E001 LEGEND, ONE-LINE, SCHEDULES AND NOTES  
E002 PANEL SCHEDULE, BATHROOM DETAIL  
E101 LEVEL 100 FLOOR PLAN  
E102 LEVEL 200 FLOOR PLAN  
E103 LEVEL 300 FLOOR PLAN  
E111 FIRST FLOOR  
E112 SECOND FLOOR  
E113 THIRD FLOOR

LOCATION MAP

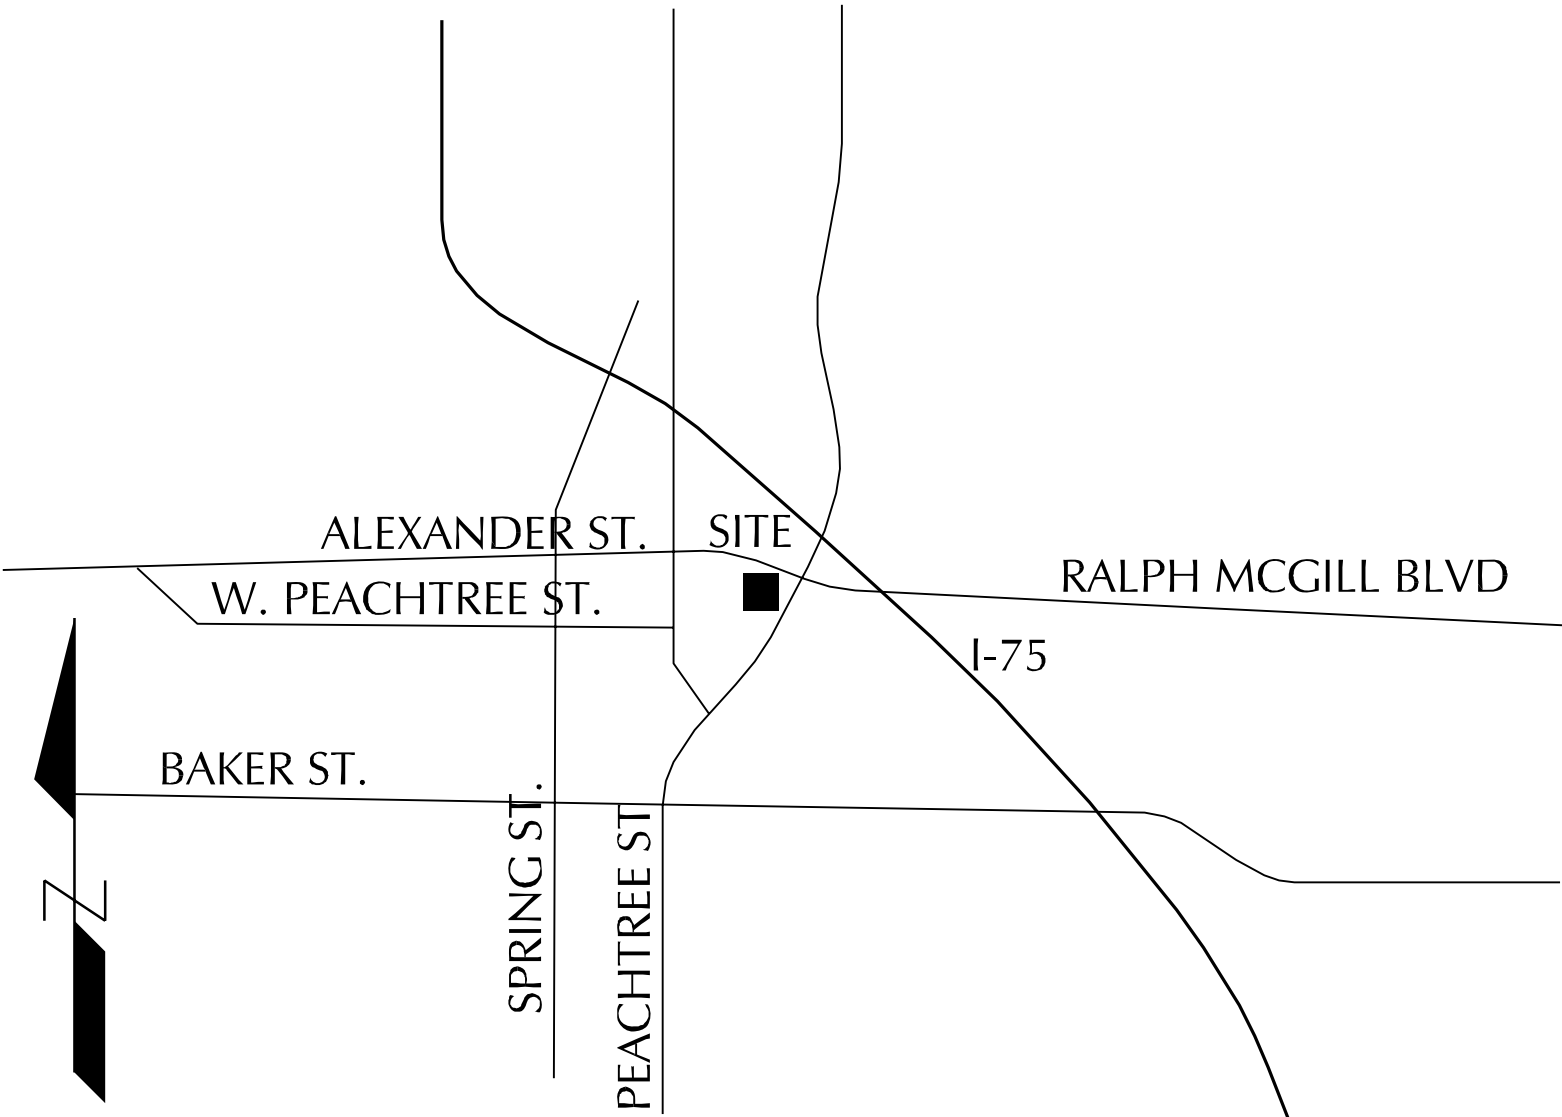

10/04/2007  
15 BUILT DRAWINGS

CONSULTANTS

ARCHITECT

KEN BASS  
CDH PARTNERS INC.  
675 TOWER ROAD  
MARIETTA, GEORGIA 30060  
PHONE (770) 423-0016  
FAX (770) 424-0260

INTERIOR DESIGN

TOVA SERDA  
CDH PARTNERS INC.  
675 TOWER ROAD  
MARIETTA, GEORGIA 30060  
PHONE (770) 423-0016  
FAX (770) 424-0260

STRUCTURAL ENGINEER

GREG PETERSON  
NORTON, SCHMIDT & WARDEN  
4562 LAWRENCEVILLE HWY  
SUITE 120  
LILBURN, GEORGIA 30047  
PHONE: (770) 934-6944  
FAX: (770) 934-1875

MECHANICAL ENGINEER

GARY GABRIEL  
CDH PARTNERS INC.  
675 TOWER ROAD  
MARIETTA, GEORGIA 30060  
PHONE (770) 423-0016  
FAX (770) 424-0260

ELECTRICAL ENGINEER

HANK NODZAK  
CDH PARTNERS INC.  
675 TOWER ROAD, SUITE 200  
MARIETTA, GEORGIA 30060-0260  
PHONE (770)423-0016  
FAX (770)424-0260

SET #



COPYRIGHT © 2004 by CDH PARTNERS INC.  
All rights reserved. These documents,  
as instruments of service, remain the  
property of the architect and no part  
may be used or reproduced without  
prior written permission of the  
copyright owner.

---

DRAWING NUMBER

**C101**

OF










*A*

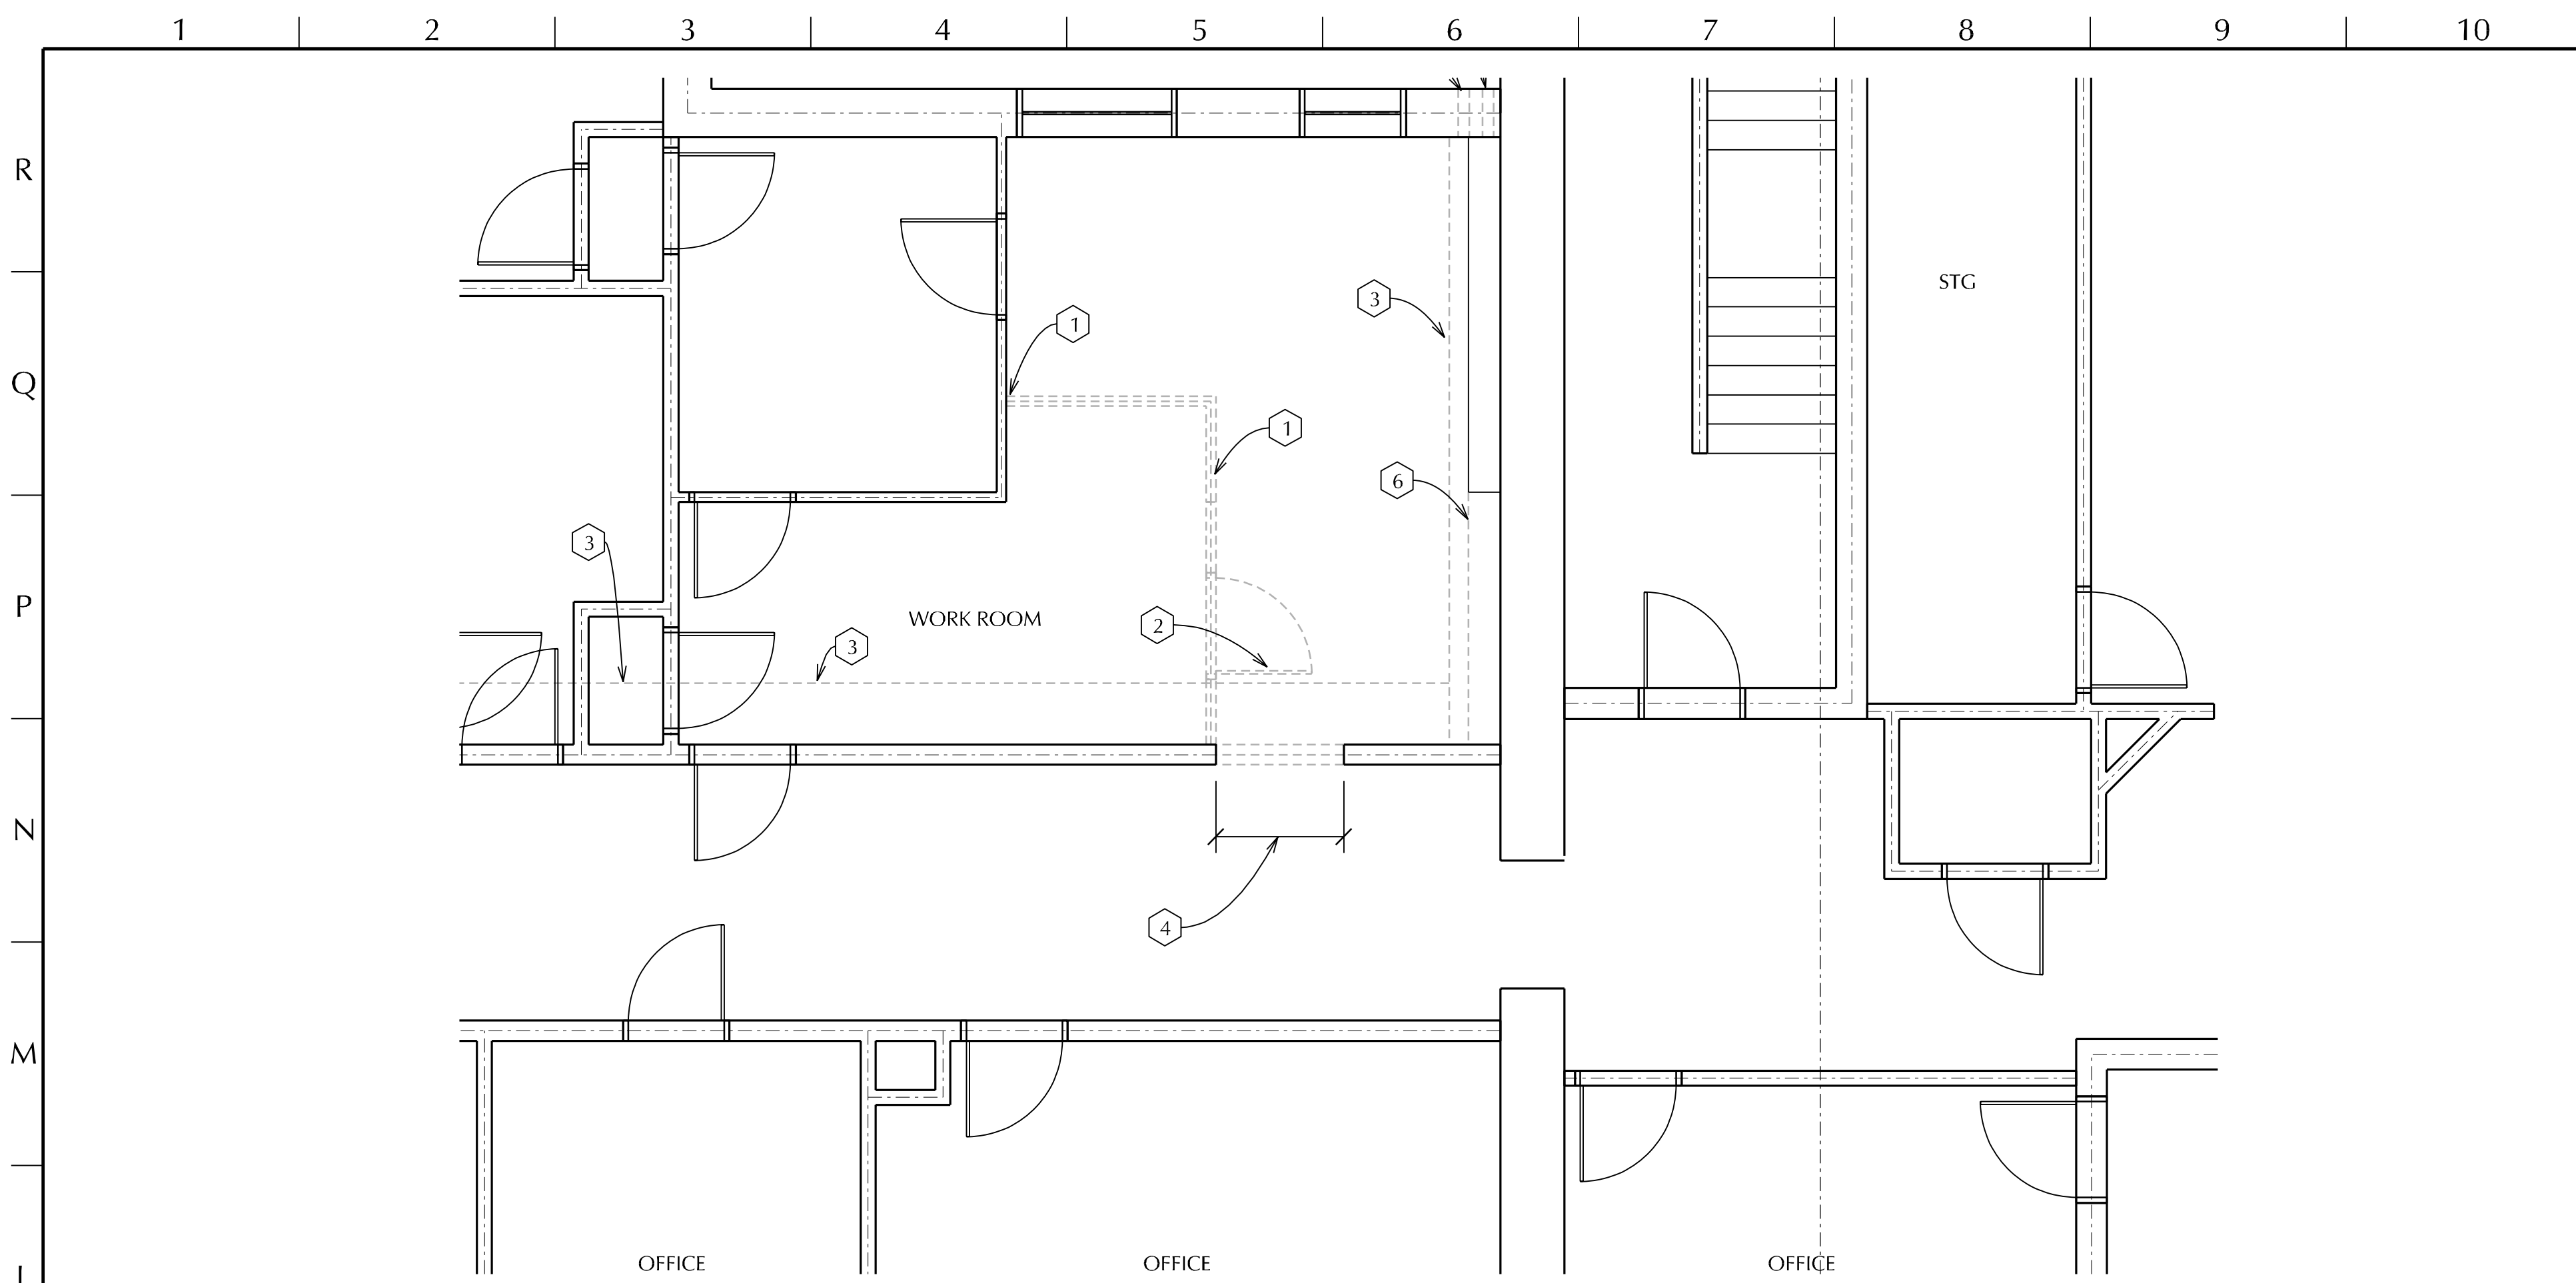


L1	LEVEL 200 DEMOLITION PLAN	
1/4" = 1'-0"	D251	XD002-5018


DEMOLITION NOTES:

1. Remove wall, inclusive of all existing utilities. Patch existing walls, designated to remain, where demo wall connects.
2. Remove existing door and frame inclusive of all hardware. in fill with new construction. flush both sides.
3. Cut ceiling and walls as need for installation of Plumb'g and Mech. Prepare area to be furred out and repainted.
4. Cut opening in wall for installation of new door. See Door schedule and floor plans for size and location.
5. Cut opening through existing exterior wall to run vent stack and exhaust duct to outside of building.
6. Remove existing shelving as required for installation of new work. provide finished end at new location matching existing.

## MATERIALS KEYING

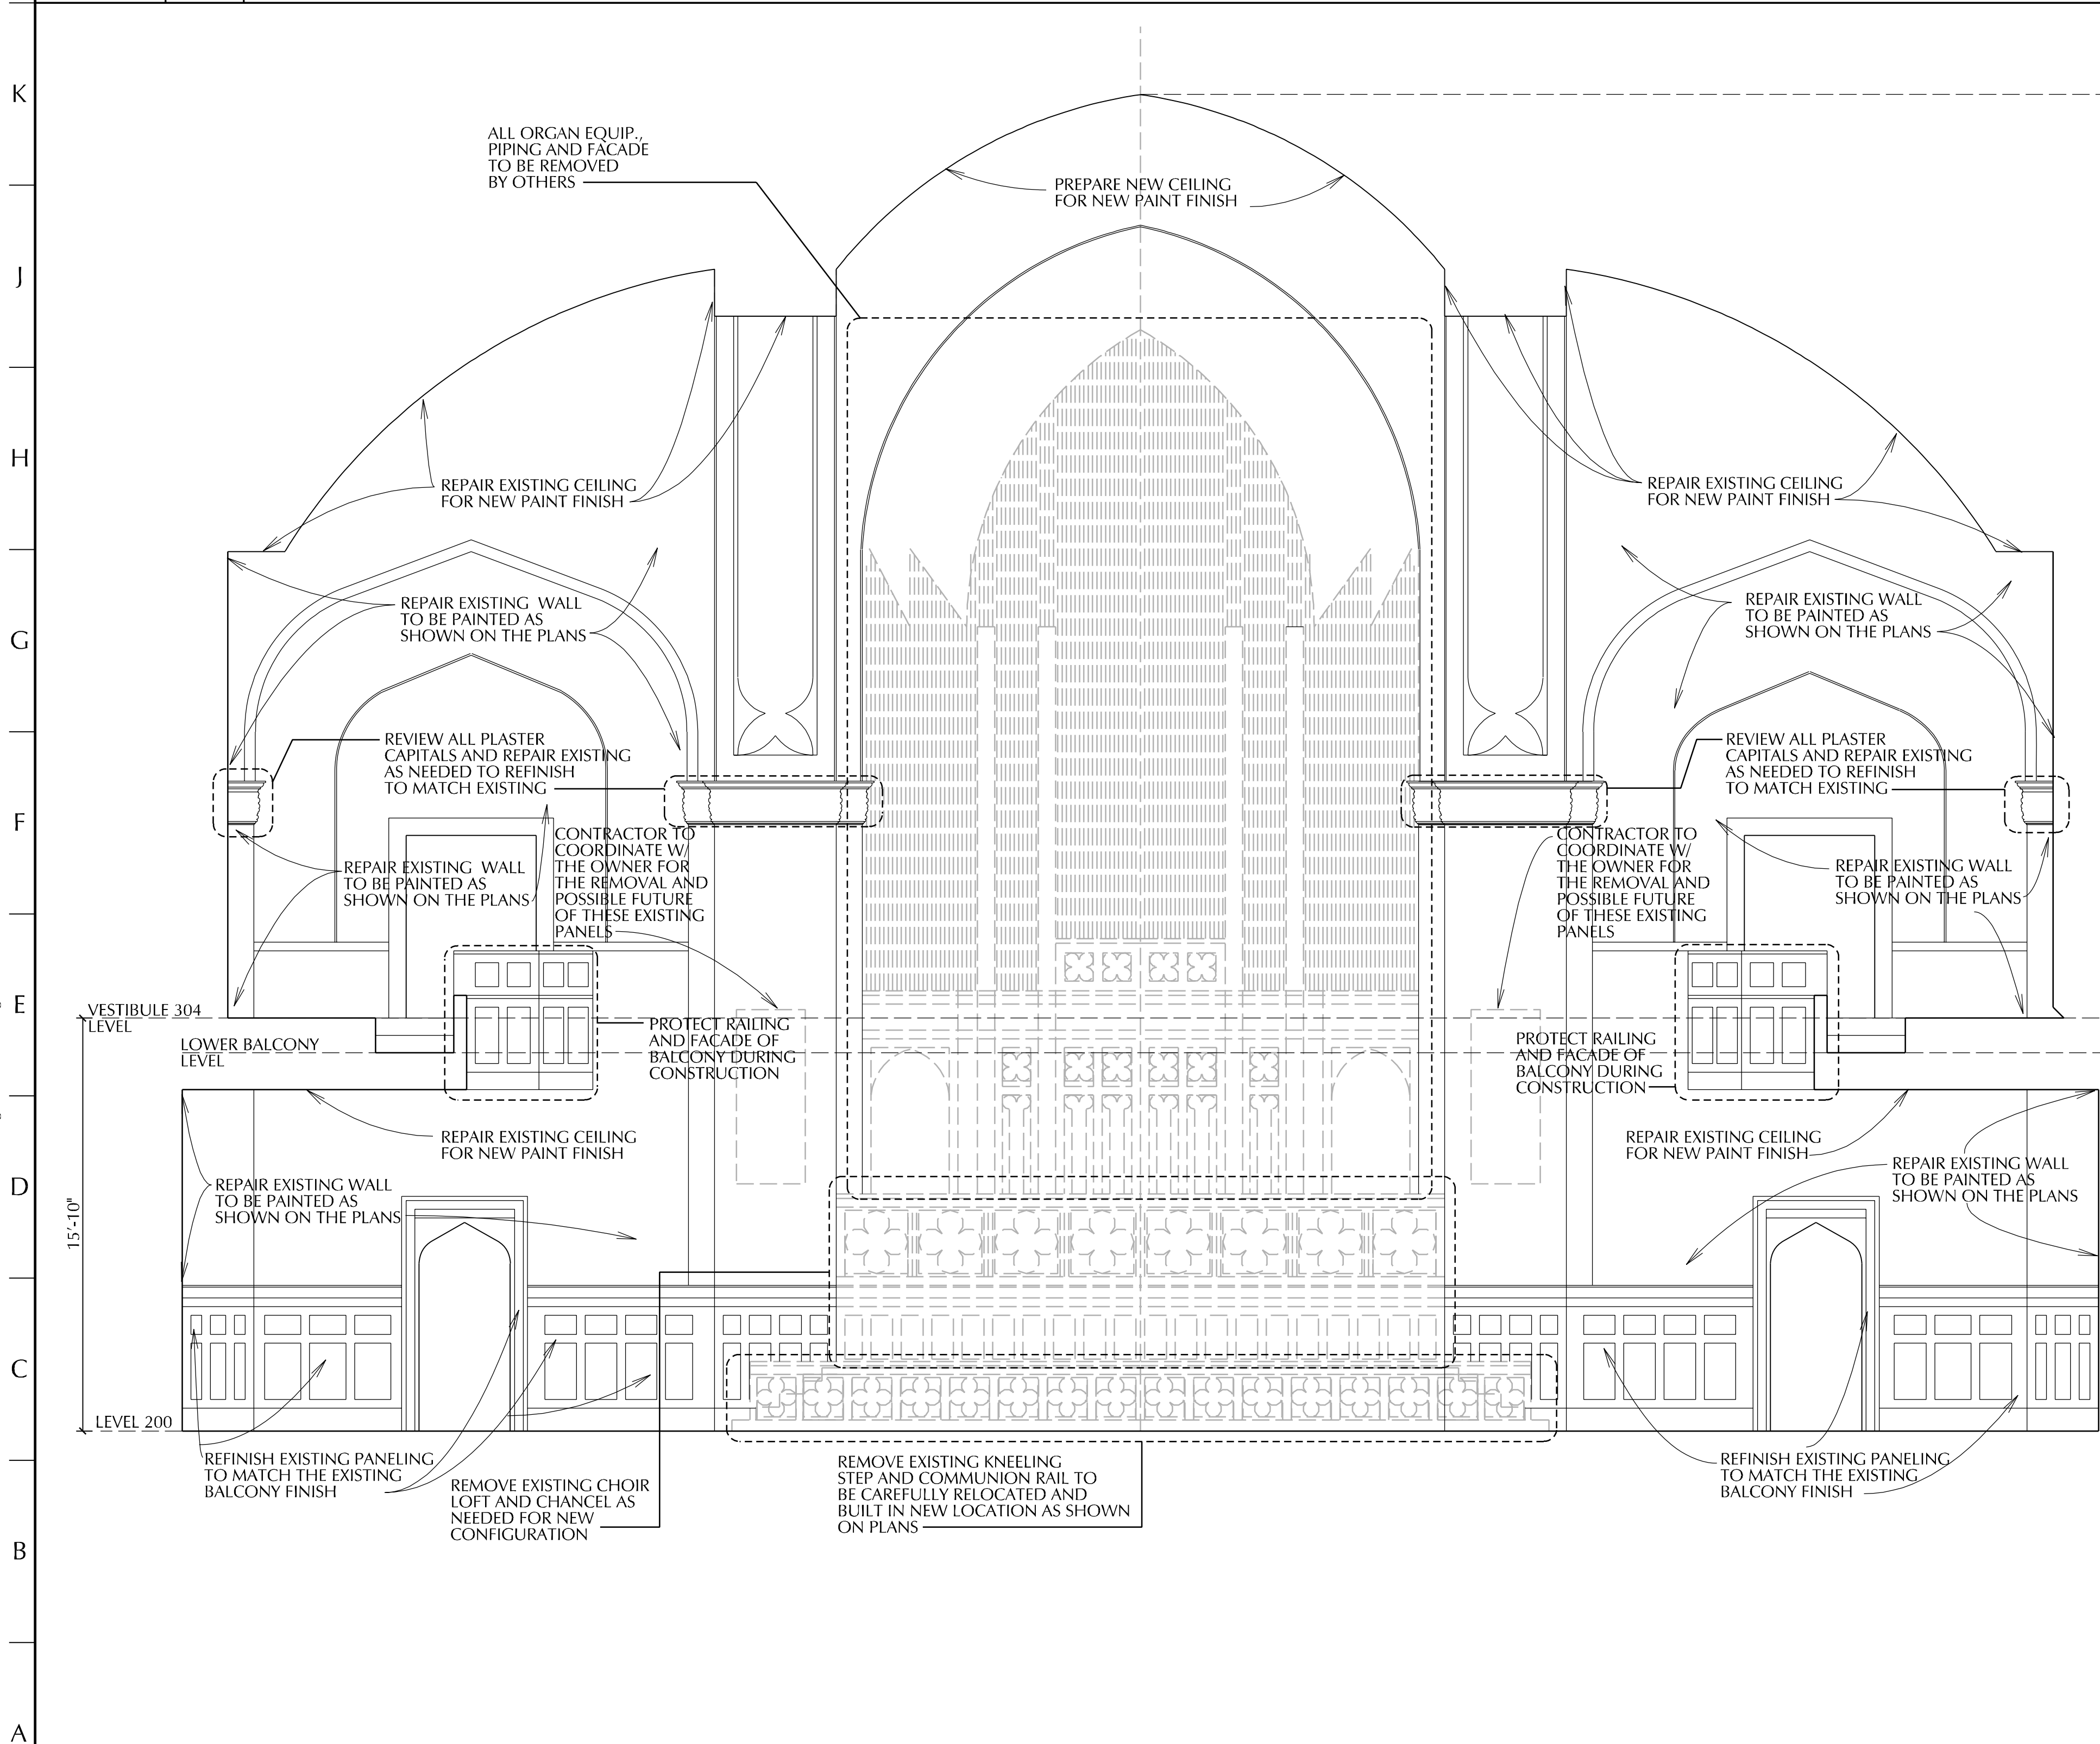

A1	DEMOLITION SECTION	
1/2" = 1'-0"	D251	BS001-5018.DGN

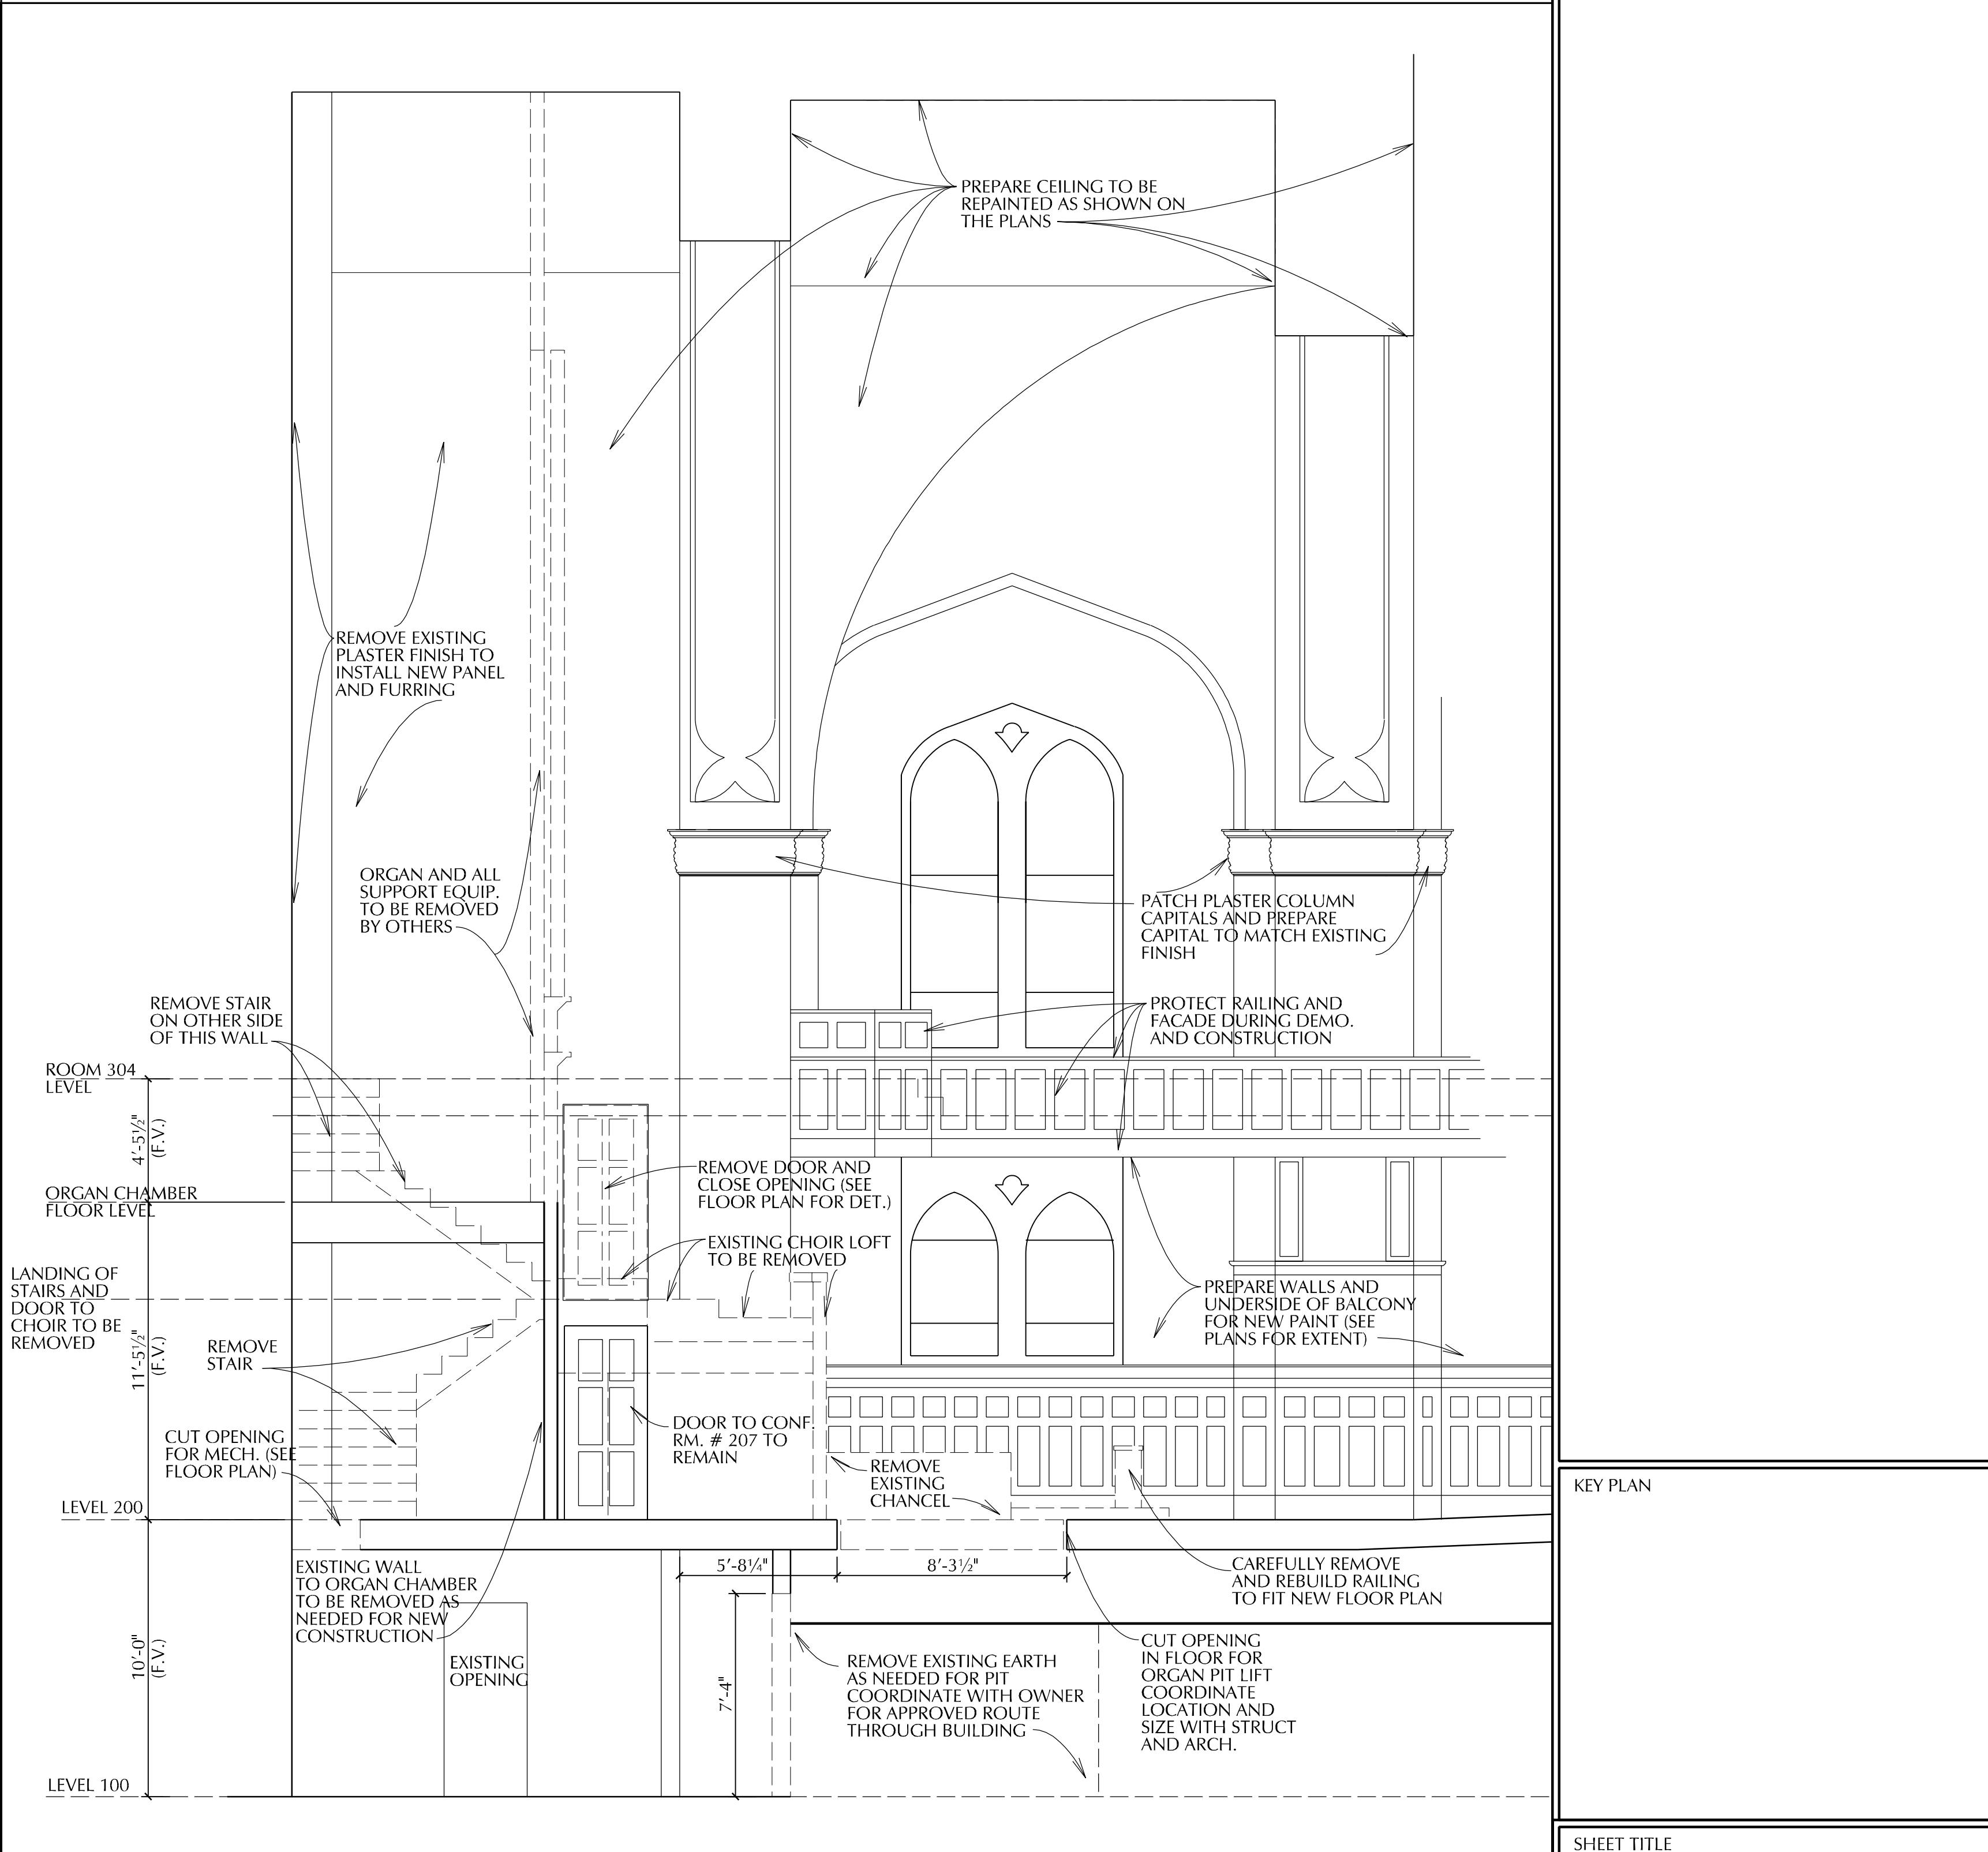


A11	DEMOLITION SECTION		DEMOLITION SECTIONS
¾"=1'-0"	D251	BS002-5018.DGN	

**CDH**  
**PARTNERS**

ARCHITECTURE  
ENGINEERING  
INTERIOR DESIGN  
CONSTRUCTION SERVICES

---

575 Tower Road  
Marietta, Ga 30060-6958  
Off: 770.423.0016  
Fax: 770.424.0260  
[www.cdhparters.com](http://www.cdhparters.com)

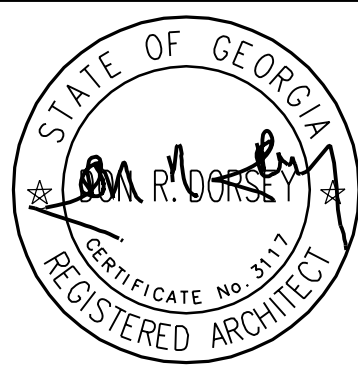

INTERIOR RENOVATION FOR  
ATLANTA FIRST  
UNITED METHODIST CHURCH  
360 PEACHTREE ST NE ATLANTA, GA 30308

10/04/2007
'AS BUILT' DRAWINGS

PROJECT NO:  
● 2005-0018





CAD FILE NAME:  
● ...\\5018d251.dgn

COPYRIGHT © 2004 by CDH PARTNERS INC.  
 All rights reserved. These documents  
 as instruments of service, remain the  
 property of the architect and no part  
 may be used or reproduced without  
 prior written permission of the  
 copyright owner.

DRAWING NUMBER  
1

# D251



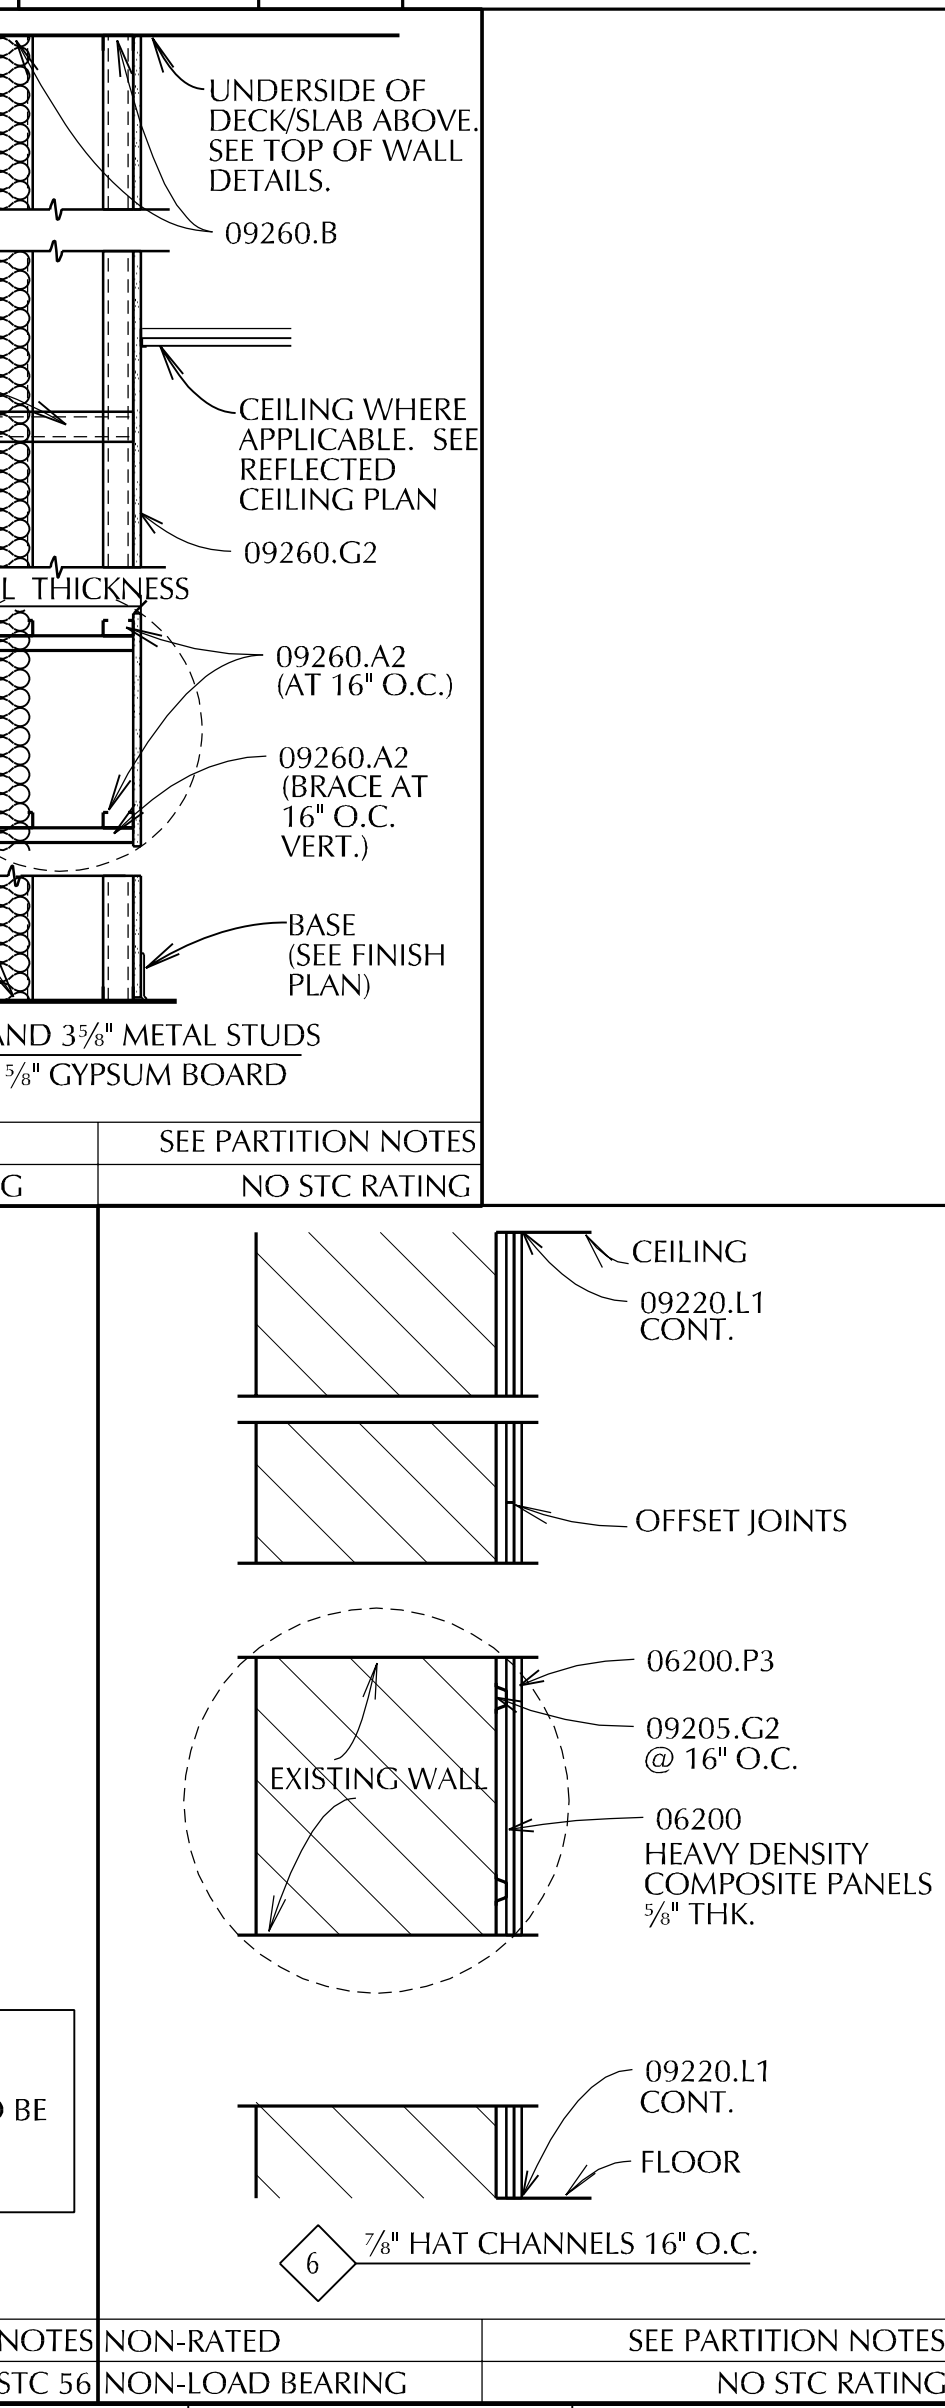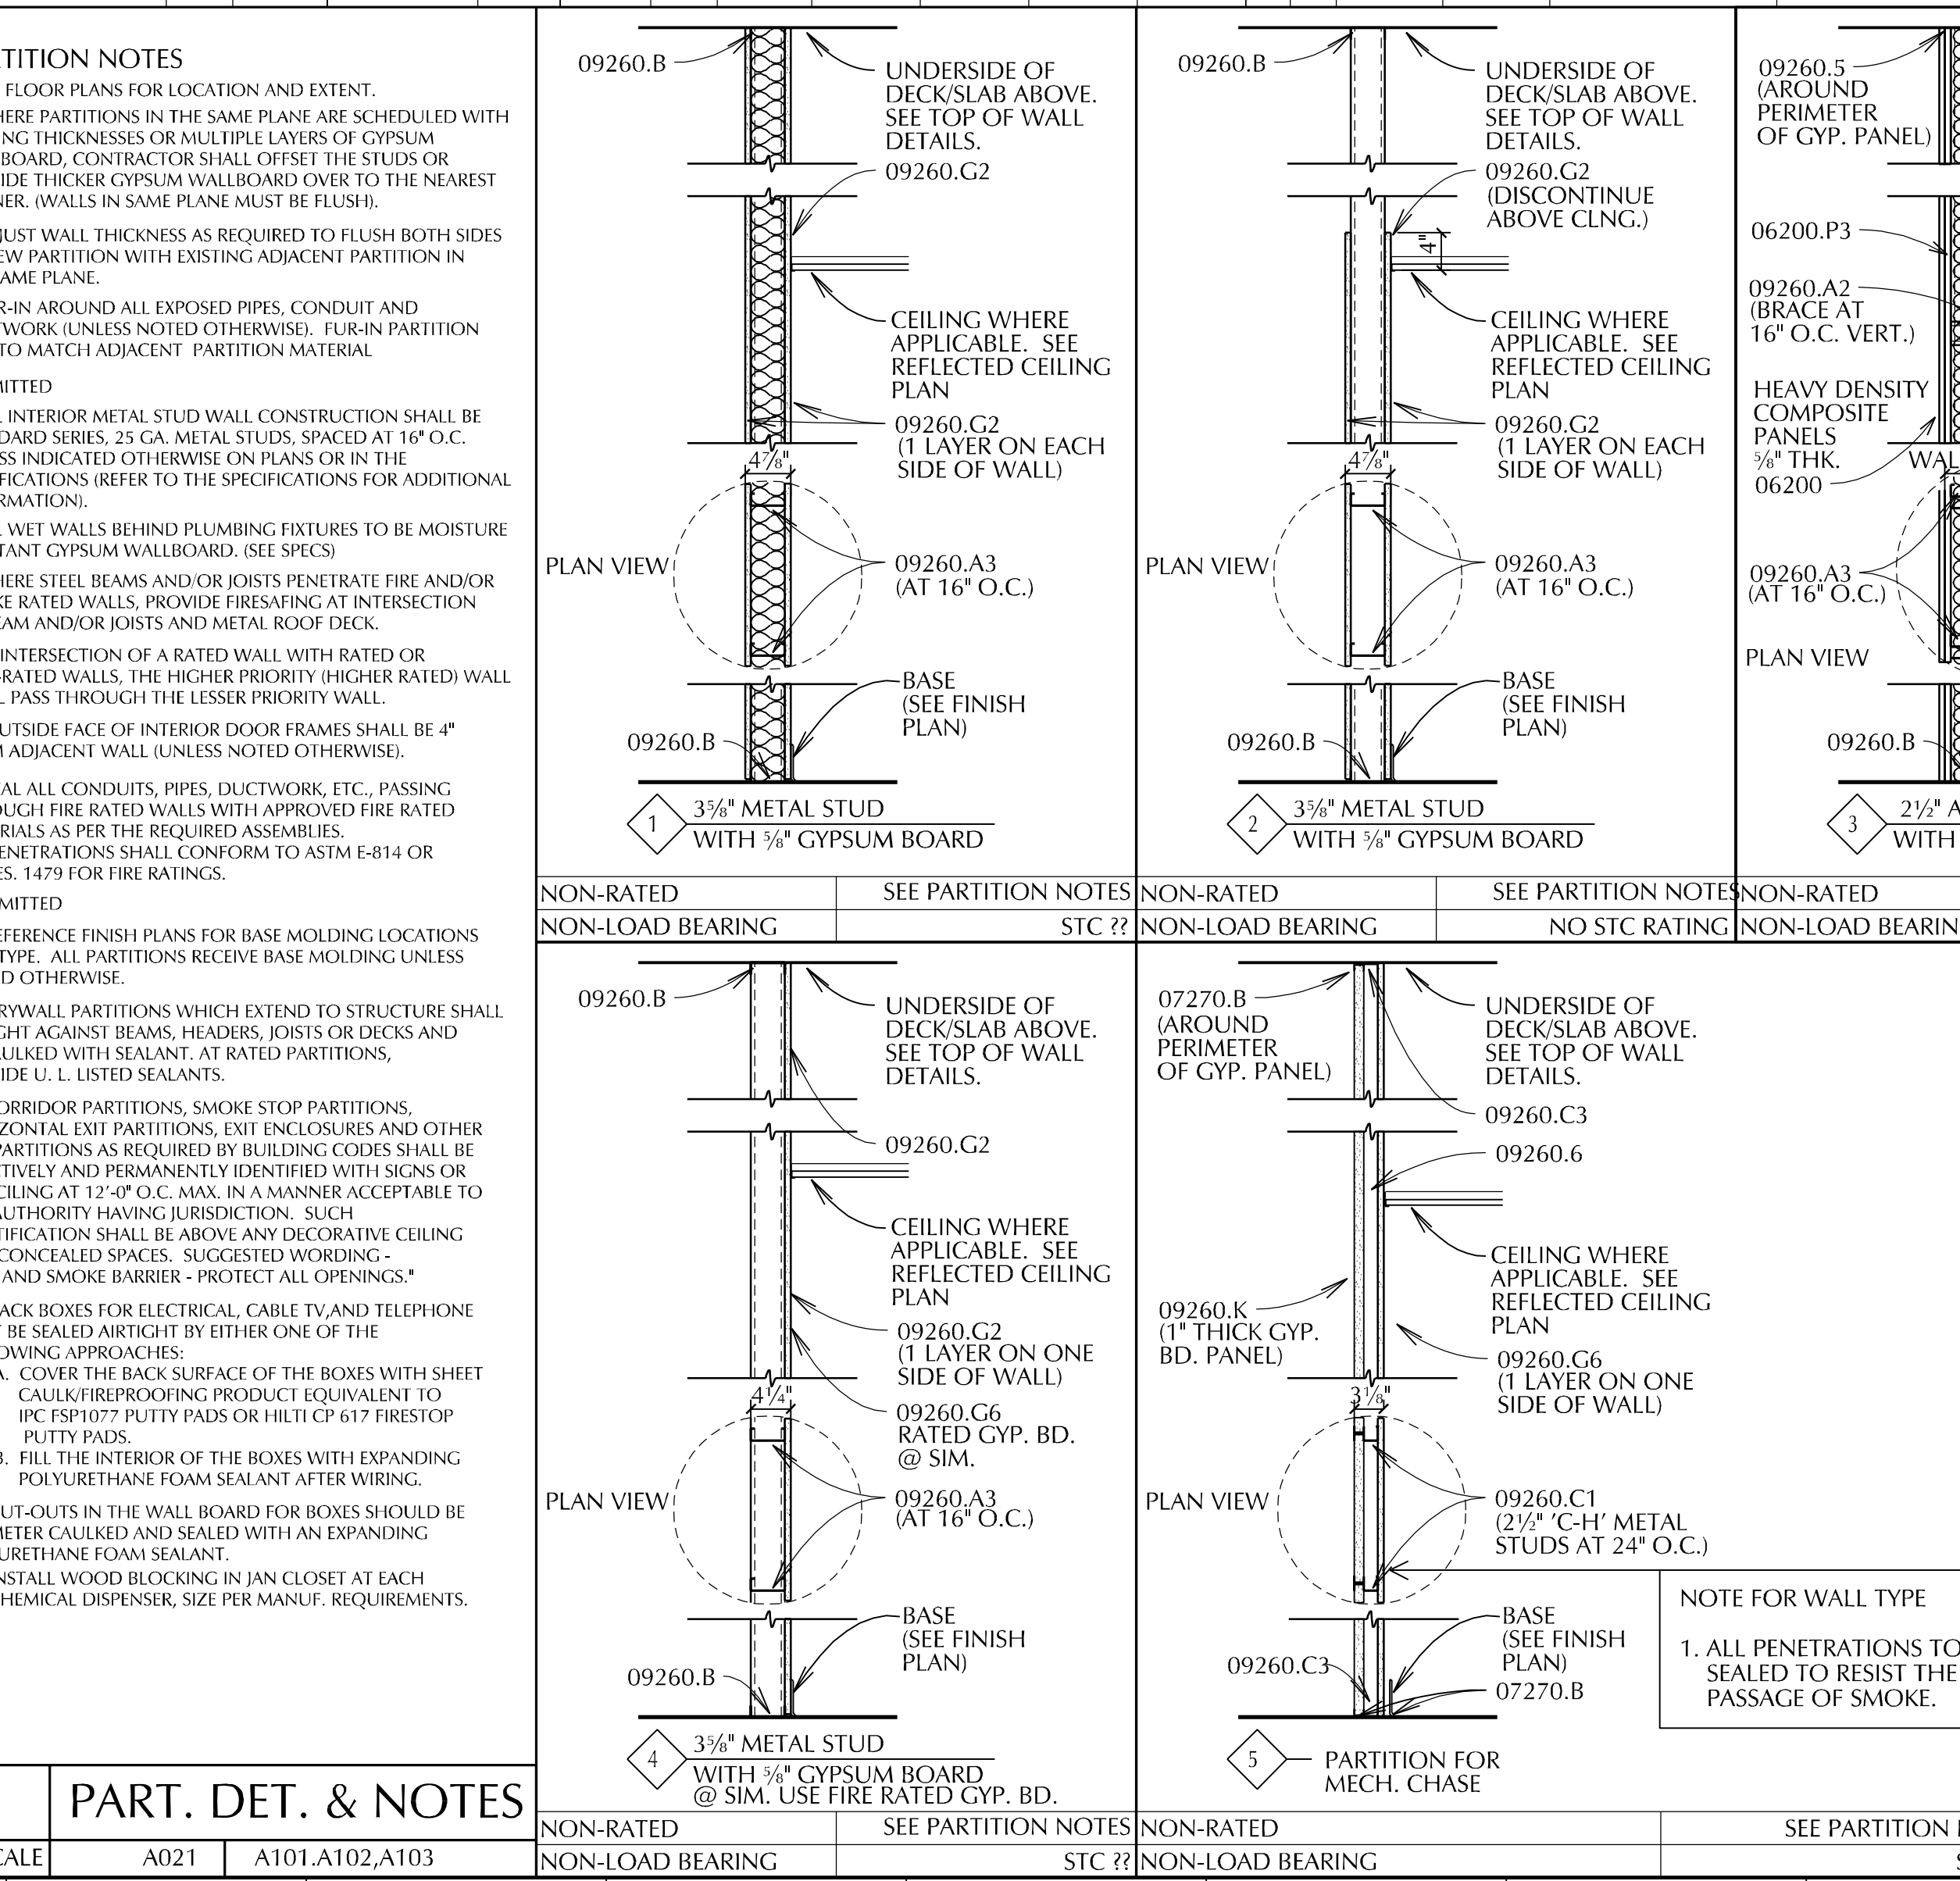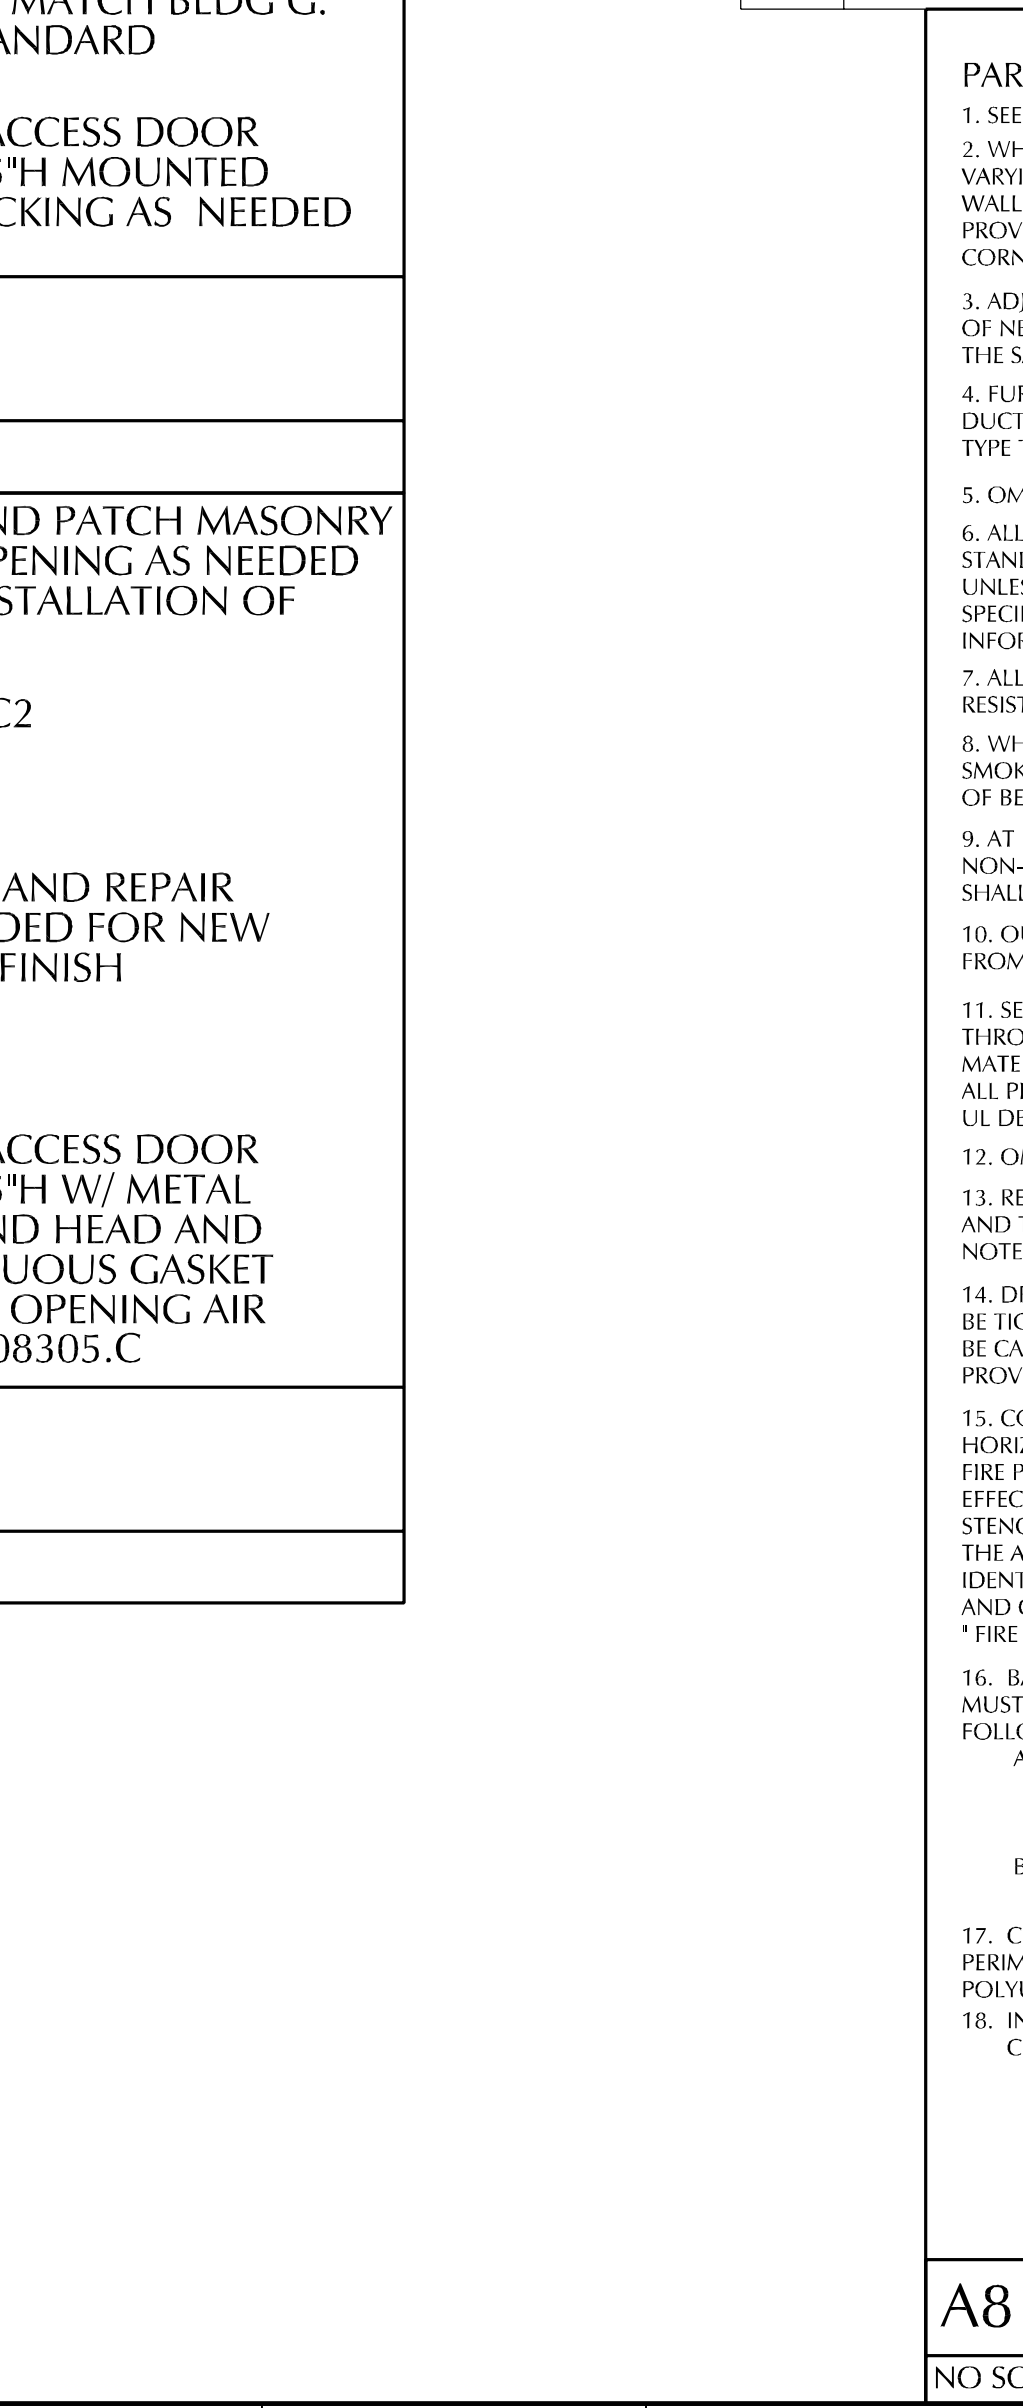 

18

19

MATERIALS KEYING

DIVISION 3 : CONCRETE

03010 CONCRETE WORK

03010.3 PRE-MOCCED JOINT FILLER

03010.4 BLOCK CONCRETE FILL

03010.C STEEL REINF. BARS - SEE STRUCT

03430 ARCHITECTURAL PRE-CAST CONCRETE

03430.4 NON-SHRINKING GROUT

DIVISION 4 : MASONRY

04220 CONCRETE UNIT MASONRY

04220.2 CML - GROUT

04220.81 NORMAL WT. CML-6x8x16-TYPE 1

DIVISION 5 : METALS

05120 STRUCTURAL STEEL

05120.C STRUCTURAL STEEL PLATE

05160 SUPPORT FRAMING SYSTEMS

05160.2 CHANNEL SUPPORT BOLT

05515 FABRICATED STEEL LADDERS

05515.A STEEL LADDER

DIVISION 6 : WOOD AND PLASTICS

06100 ROUGH CARPENTRY

06100.A5 FRAMING LUMBER 2 X 10

06100.22 EXTERIOR PLYWOOD 1/2"

06101E HOLLOW WOOD FLOOR DECKING

06101.N2 WOOD BLOCKING 2BYE

06200 FINISH CARPENTRY

06200 FINISH CARPENTRY

06200.F3 MDO PANEL 5/8"

DIVISION 7 : THERMAL AND MOISTURE PROTECTION

07270 FIRESTOPPING

07270.8 JOINT SEALANT FIRESTOP

07920 SEALANTS AND CAULKING

07920.3 MASTIC

07920.81 INT. CAULK - GENERAL PURPOSE

DIVISION 8 : DOORS AND WINDOWS

08180 HOLLOW METAL WORK

08180.A HOLLOW METAL DOOR

08180.B HOLLOW METAL DOOR FRAME

08180.D FRAME ARCH

08210 PANELED WOOD DOORS

08212 PANELED WOOD DOOR

08305 WALL AND CEILING ACCESS DOORS

08305.C WALL ACCESS DOOR

08711 FINISH HARDWARE

08711.A THRESHOLD - SET IN MASTIC

DIVISION 9 : FINISHES

09205 PORTLAND CEM. PLASTER(TUCCO)

09205.G2 INTERIOR FURRING HAT CHANNEL

09210 VERTICAL PLASTER

09210 PLASTER

09220 INTERIOR CONVENTIONAL PLASTER

09220.11 ACOUSTICAL SEALANT

09260 GYPSSUM WALLBOARD SYSTEMS

09260.5 ACOUSTICAL SEANT

09260.6 SOUND ATTENUATION BATT - 2"

09260.63 STD. SERIES MTL. STUD 2-1/2"

09260.64 STD. SERIES MTL. STUD - 3-5/8"

09260.6E METAL STUD RUNNER

09260.C1 SHAFT WALL STUD-2 1/2"

09260.C3 SHAFT WALL ESTUD - 2 1/2"

09260.C2 GYP WALLBOARD - REG. - 5/8"

09260.6C GYP WALLBOARD FIRE RATED 5/8"

09260.K GYPSUM SHAFT LINER PANEL 1"

09310 CERAMIC TILE

09310 CERAMIC TILE

09310.E CERAMIC TILE THIN SET BED

09310.K MARBLE THRESHOLD @ CER TILE

09571 WOOD PARQUET FLOORING

09571 WOOD PARQUET FLOORING

09660 RESILIENT TILE FLOORING

09660 RESILIENT TILE FLOORING

09665 RESILIENT SHEET FLOORING

09665 RESILIENT SHEET FLOORING

GLAZING SCHEDULE

(A) 1/2" CLEAR FLOAT GLASS

(B) 1/2" CLEAR TEMPERED FLOAT GLASS

(C) 1/2" TINTED TEMPERED FLOAT GLASS

(D) 1/2" TINTED HEAT STRENGTHENED SPANDREL GLASS

(E) 1/2" TINTED HEAT STRENGTHENED INSULATING GLASS

(F) 1/2" TINTED TEMPERED INSULATING GLASS

(G) 1/2" CLEAR WIRE GLASS

HARDWARE FUNCTION LEGEND

PK Passage Latch Set

DB Dead Bolt

PR Privacy Lock Set

PP Push/Pull

OL Office Lock Set

KPY Key Pad Lock

CL Classroom Lock Set

EXIT Exit Hardware Set

SL Storage Lock Set

BU/D BU/D

DOOR AND FRAME SCHEDULE NOTES

1. All door hardware shall be Handicap Accessible, complying with ANSI A117.1-1986, Section 4.13.9.

2. Unless noted otherwise, the door and frame finishes shall be as follows:

Hollow Metal Doors:  
Wood Doors:  
Wood Frames:  
Exit Hardware:

Paint (To Match Exit)  
Paint (To Match Exit)  
Stain (To Match Exit)  
Stain (To Match Exit)  
To Match Existing Hardware in Color Style and Finish.

3. All Frames will Match Building Standard. Contractor to Review & Use and Inform Architect if any Frames are a different Material than what is shown on the Drawings.

4. Contractor to use Existing Doors where possible.

5. Contractor to provide a Continuous Air Tight seal around Existing Door, including Sill, to prevent unwanted air infiltration into the Room.

6. All Hardware by Lift Manufacturer. Contractor to coordinate finished opening size with Lift Manufacturer.

7. Install coat hook on back of door.

8. Provide High Density Core for Organ Chamber Door.

9. Lift Manufacturer must match Existing Colors of Sanctuary and have them approved by the Architect prior to finishing and installation of equipment.

10. Replace Hardware W/ Handicapped Accessible Hardware if Cost Hardware doesn't meet ANSI A117.1-1986 Requirements.

11. Contractor to provide to Door Door.

12. Contractor to Coordinate panel design between Lift Manufacturer and Architect.

13. Contractor to Coordinate door height with framing of Chair Loft and Architect.


14. Provide ADAAG compliant unique signage.

KEY PLAN

SHEET TITLE

DOOR SCHEDULES & PARTITION TYPES

[illegible]

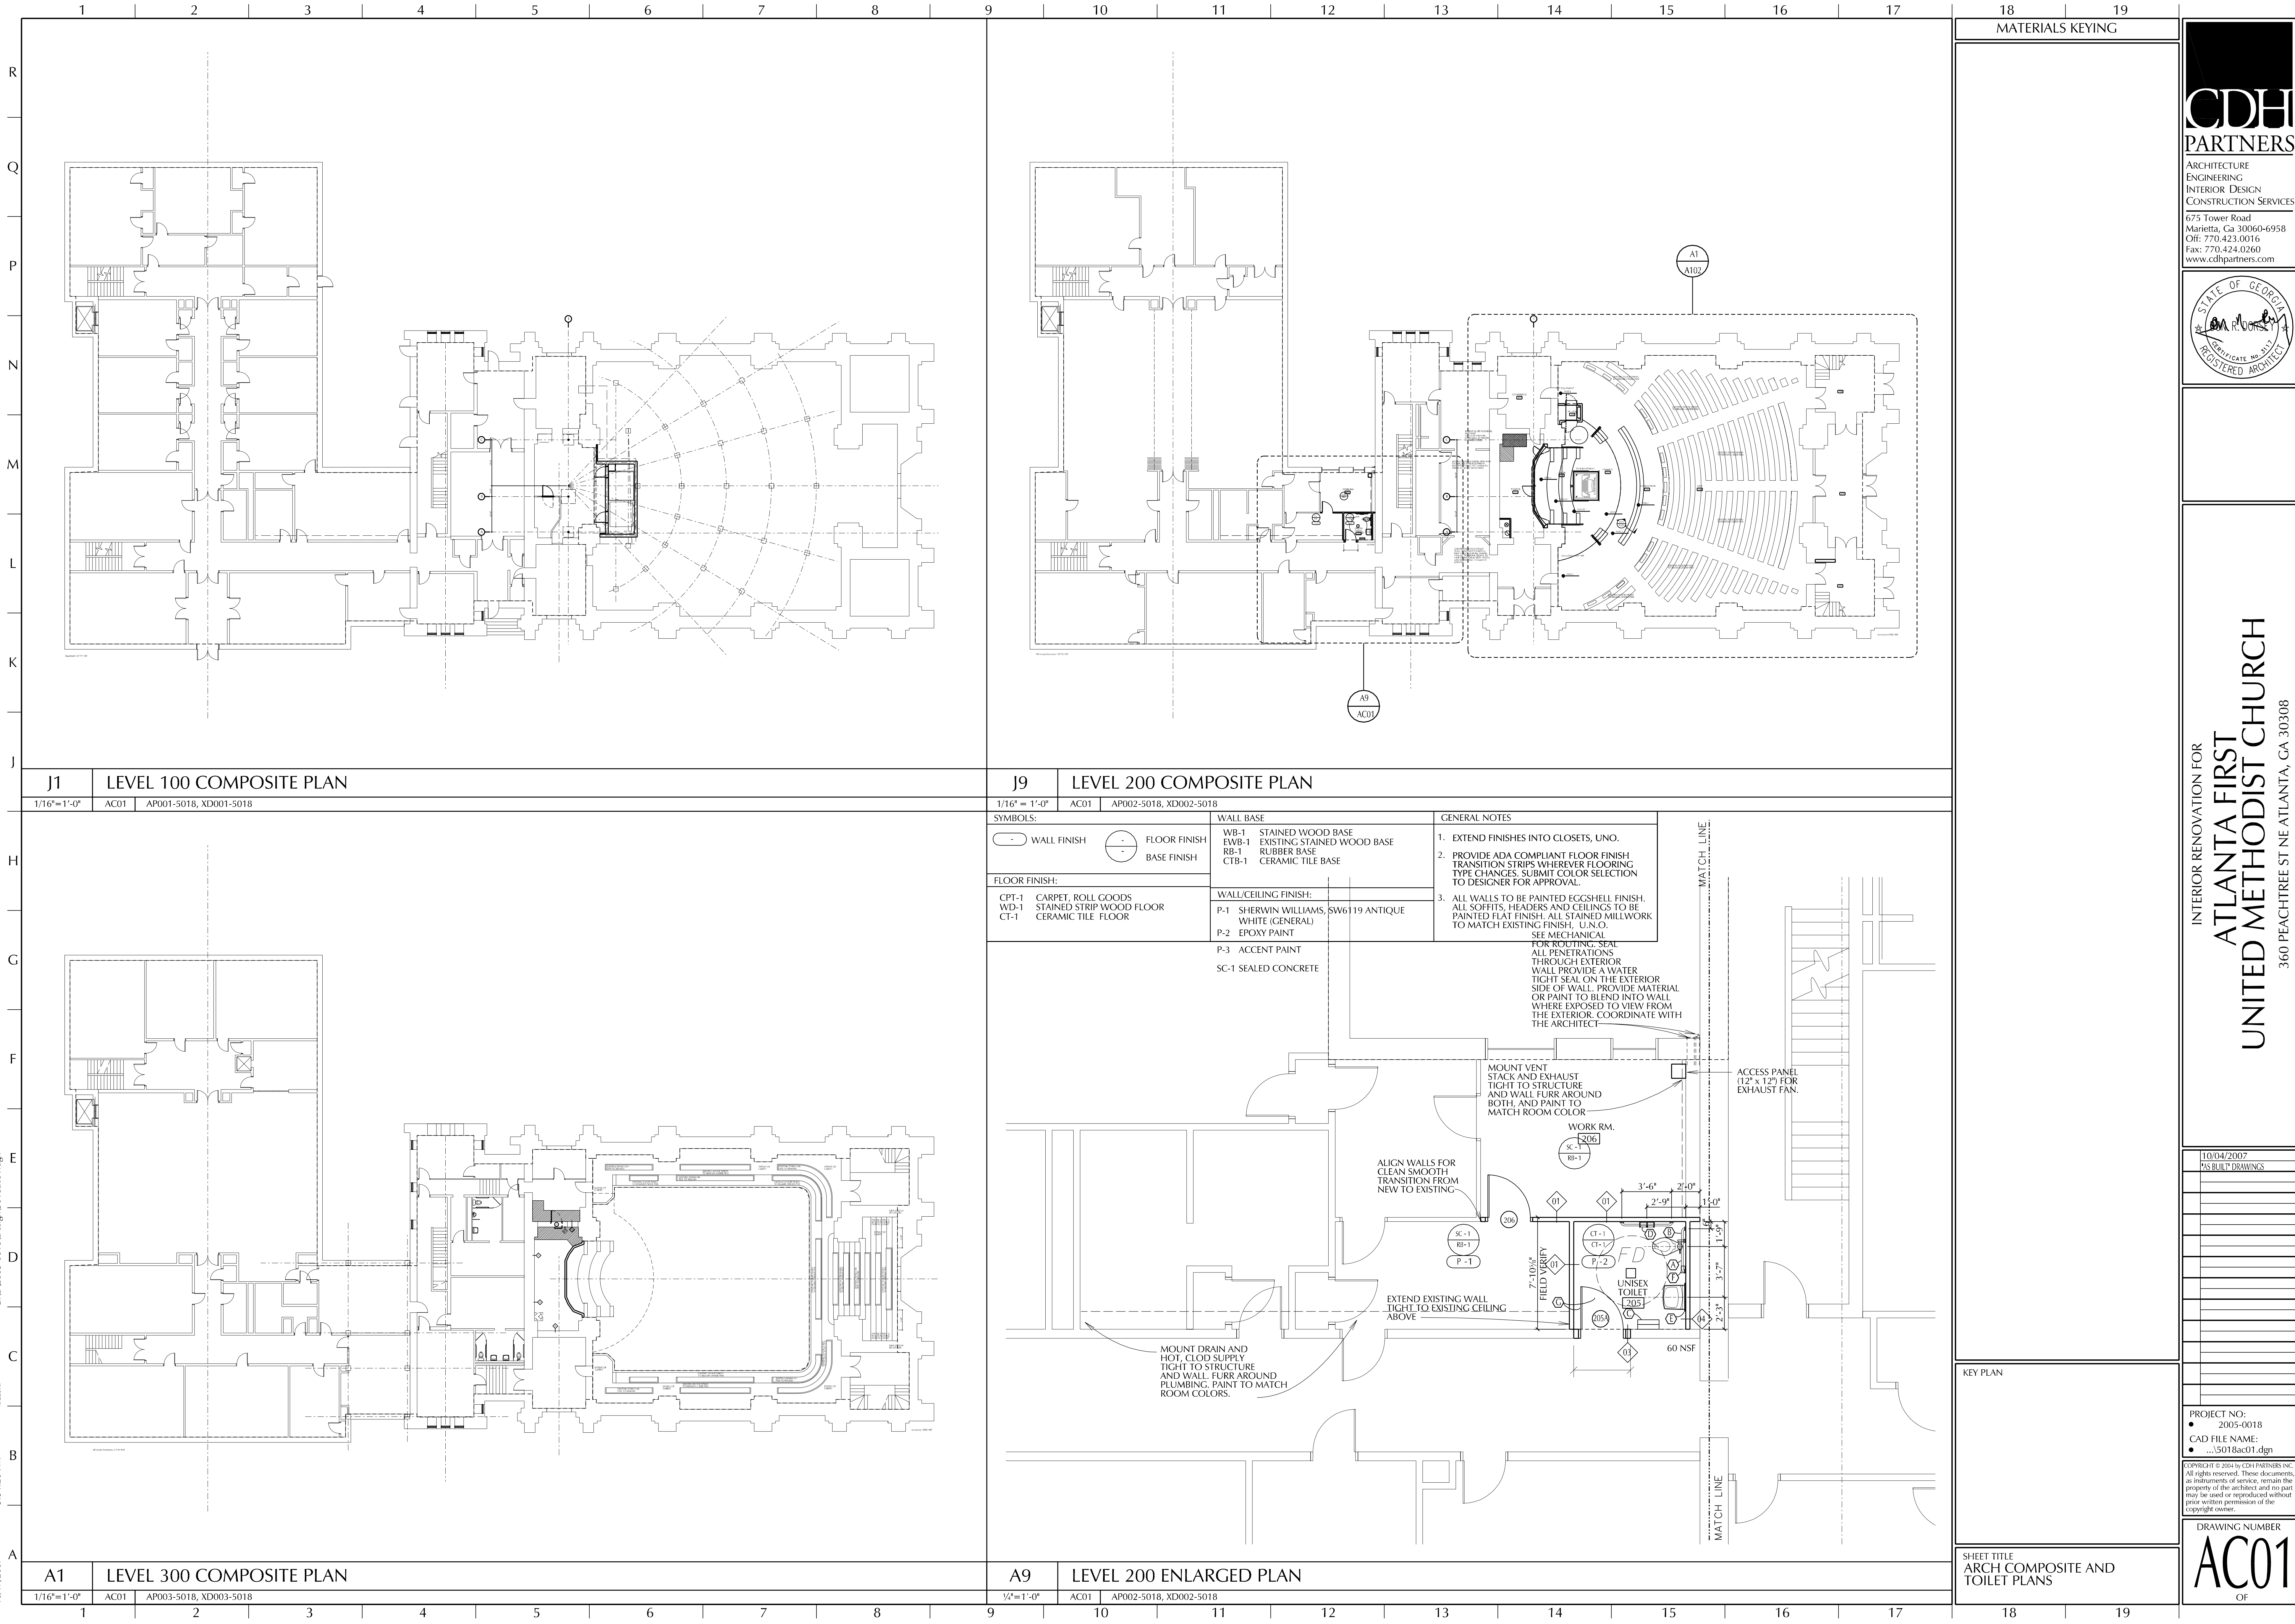

10/17/2007 5:54:20 PM baskf C:\D\2005-0018\Design\01\Bac01.dgn

CDH PARTNERS

ARCHITECTURE  
ENGINEERING  
INTERIOR DESIGN  
CONSTRUCTION SERVICES

675 Tower Road  
Marietta, Ga 30060-6958  
Off: 770.423.0016  
Fax: 770.424.0260  
www.cdhpartners.com

STATE OF GEORGIA  
REGISTERED ARCHITECT  
JAMES R. CUNNINGHAM  
LICENSE # 2005-0018

INTERIOR RENOVATION FOR  
ATLANTA FIRST  
UNITED METHODIST CHURCH  
360 PEACHTREE ST NE ATLANTA, GA 30308

11/04/2007  
755 BUILT DRAWINGS



PROJECT NO:  
2005-0018  
CAD FILE NAME:  
...05018Bac01.dgn

COPYRIGHT © 2004 by CDH PARTNERS INC.  
All rights reserved. These documents, as instruments of service, remain the property of the architect and no part may be used or reproduced without prior written permission of the copyright owner.

DRAWING NUMBER  
AC01  
OF





SYMBOLS:	
	WALL FINISH
	FLOOR FINISH
	BASE FINISH
FLOOR FINISH:	
CPT-1	CARPET, ROLL GOODS
WD-1	STAINED STRIP WOOD FLOOR
CT-1	CERAMIC TILE FLOOR

**GENERAL NOTES**

1. EXTEND FINISHES INTO CLOSETS, UNO.
2. PROVIDE ADA COMPLIANT FLOOR FINISH TRANSITION STRIPS WHEREVER FLOORING TYPE CHANGES. SUBMIT COLOR SELECTION TO DESIGNER FOR APPROVAL.
3. ALL WALLS TO BE PAINTED EGGSHELL FINISH. ALL SOFFITS, HEADERS AND CEILINGS TO BE PAINTED FLAT FINISH. ALL STAINED MILLWORK TO MATCH EXISTING FINISH, U.N.O.

**CDH**  
**PARTNERS**  
ARCHITECTURE  
ENGINEERING  
INTERIOR DESIGN  
CONSTRUCTION SERVICES


675 Tower Road  
Marietta, GA 30060-6958  
Off: 770.423.0016  
Fax: 770.424.0260  
[www.cdhpartners.com](http://www.cdhpartners.com)


STATE OF GEORGIA  
JAMES R. DUNSTON  
CERTIFICATE NO. 3117  
REGISTERED ARCHITECT


INTERIOR RENOVATION FOR  
ATLANTA FIRST  
UNITED METHODIST CHURCH  
360 PEACHTREE ST NE ATLANTA, GA 30308






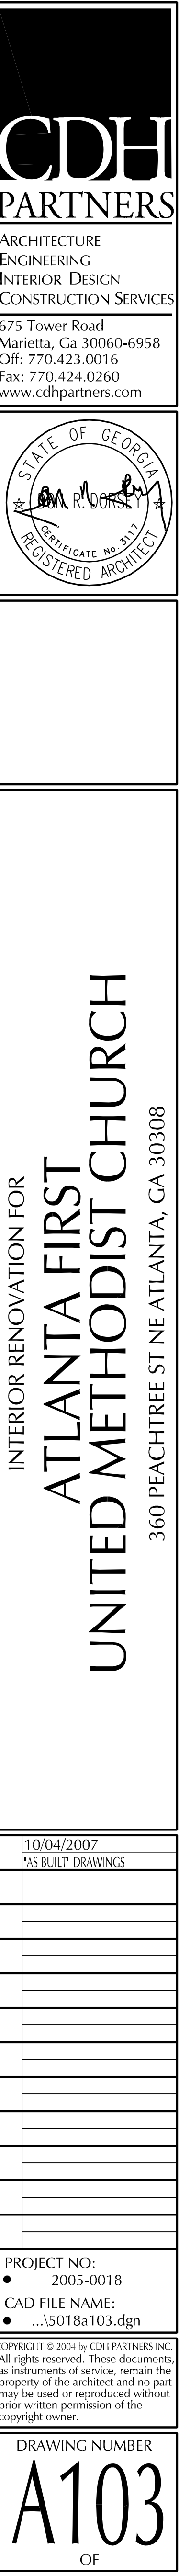


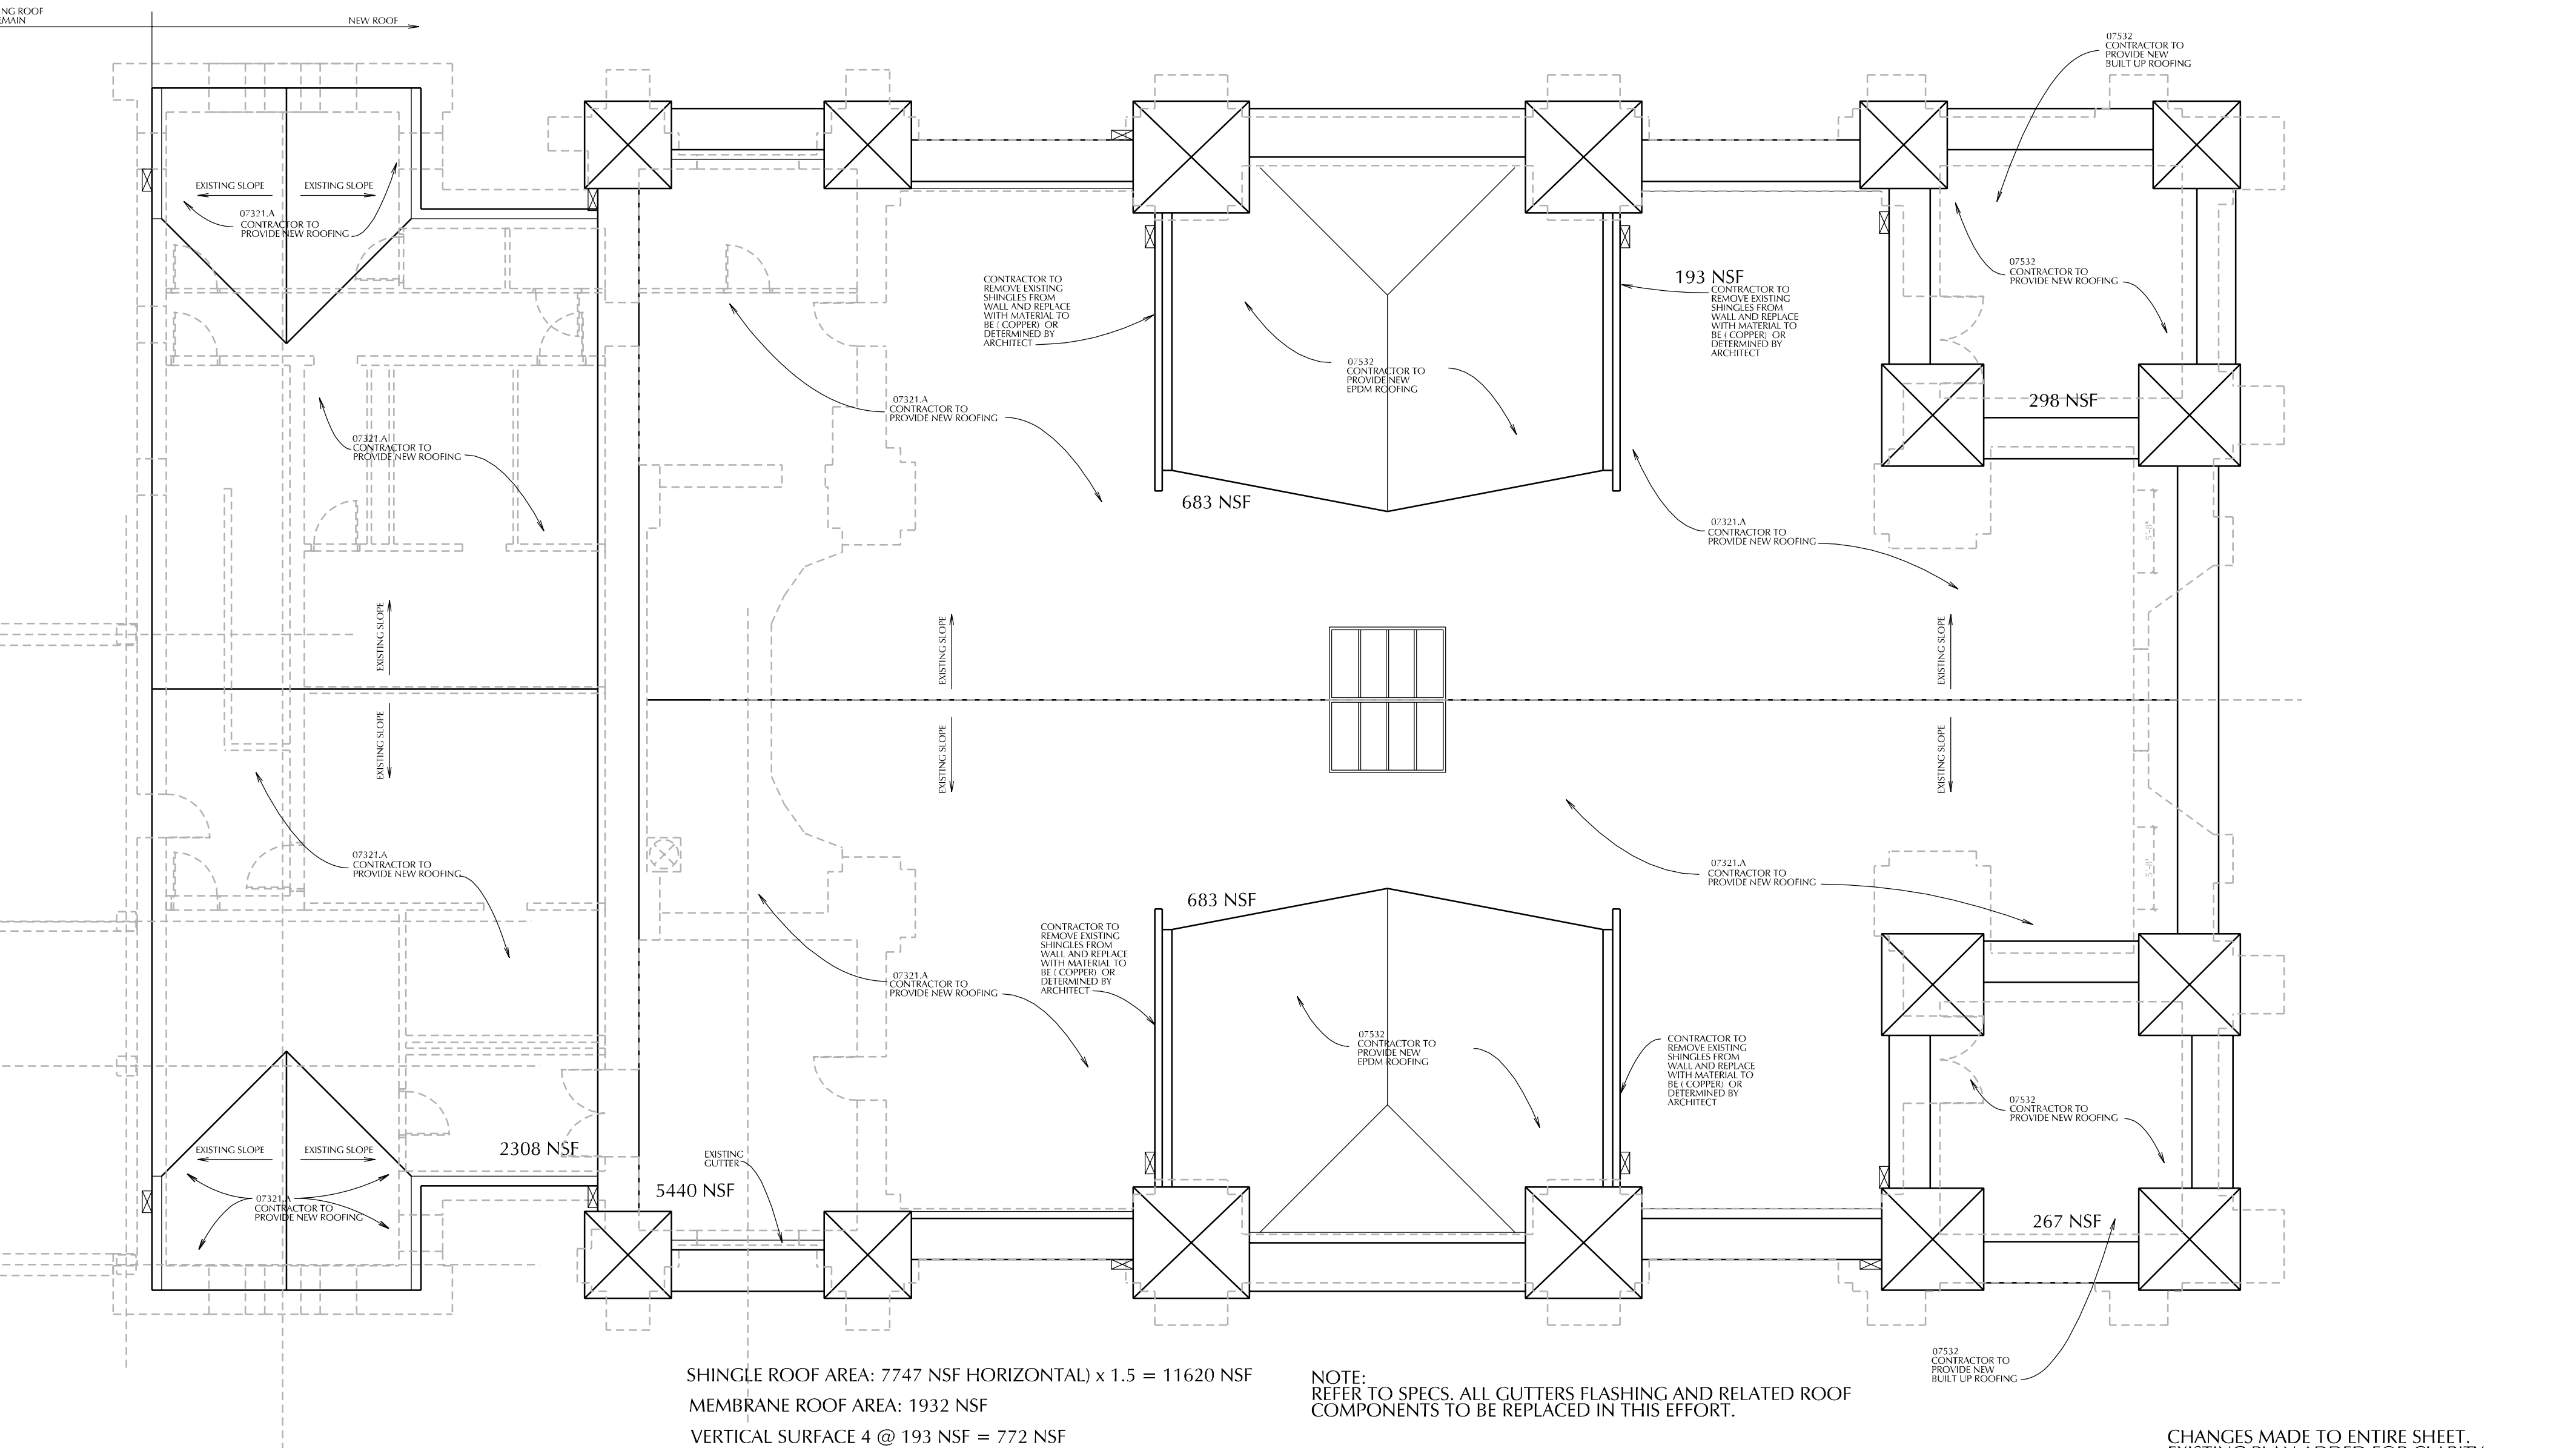[illegible]

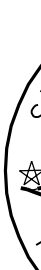 <p>ARCHITECTURE ENGINEERING INTERIOR DESIGN CONSTRUCTION SERVICES</p> <p>675 Tower Road Marietta, Ga 30060-6958 Off: 770.423.0016 Fax: 770.424.0260 www.cdhppartners.com</p>	
	
<p>INTERIOR RENOVATION FOR</p> <p><b>ATLANTA FIRST</b></p> <p><b>UNITED METHODIST CHURCH</b></p> <p>360 PEACHTREE ST NE ATLANTA, GA 30308</p>	
<p>10/04/2007</p> <p>AS BUILT DRAWINGS</p>	
<p>PROJECT NO: 2005-0018</p> <p>CAD FILE NAME: \AS1018a151.dgn</p> <p>© COPYRIGHT © 2004 BY CDHP PARTNERS INC. All rights reserved. These documents, as instruments of service, remain the property of the architect and no part may be used or reproduced without prior written permission of the copyright owner.</p> <p>DRAWING NUMBER</p> <p><b>A151</b></p> <p>OF</p>	



10/17/2007 5:54:56 PM baskf C:\D\2005-0018\Design\01Ba251.dgn

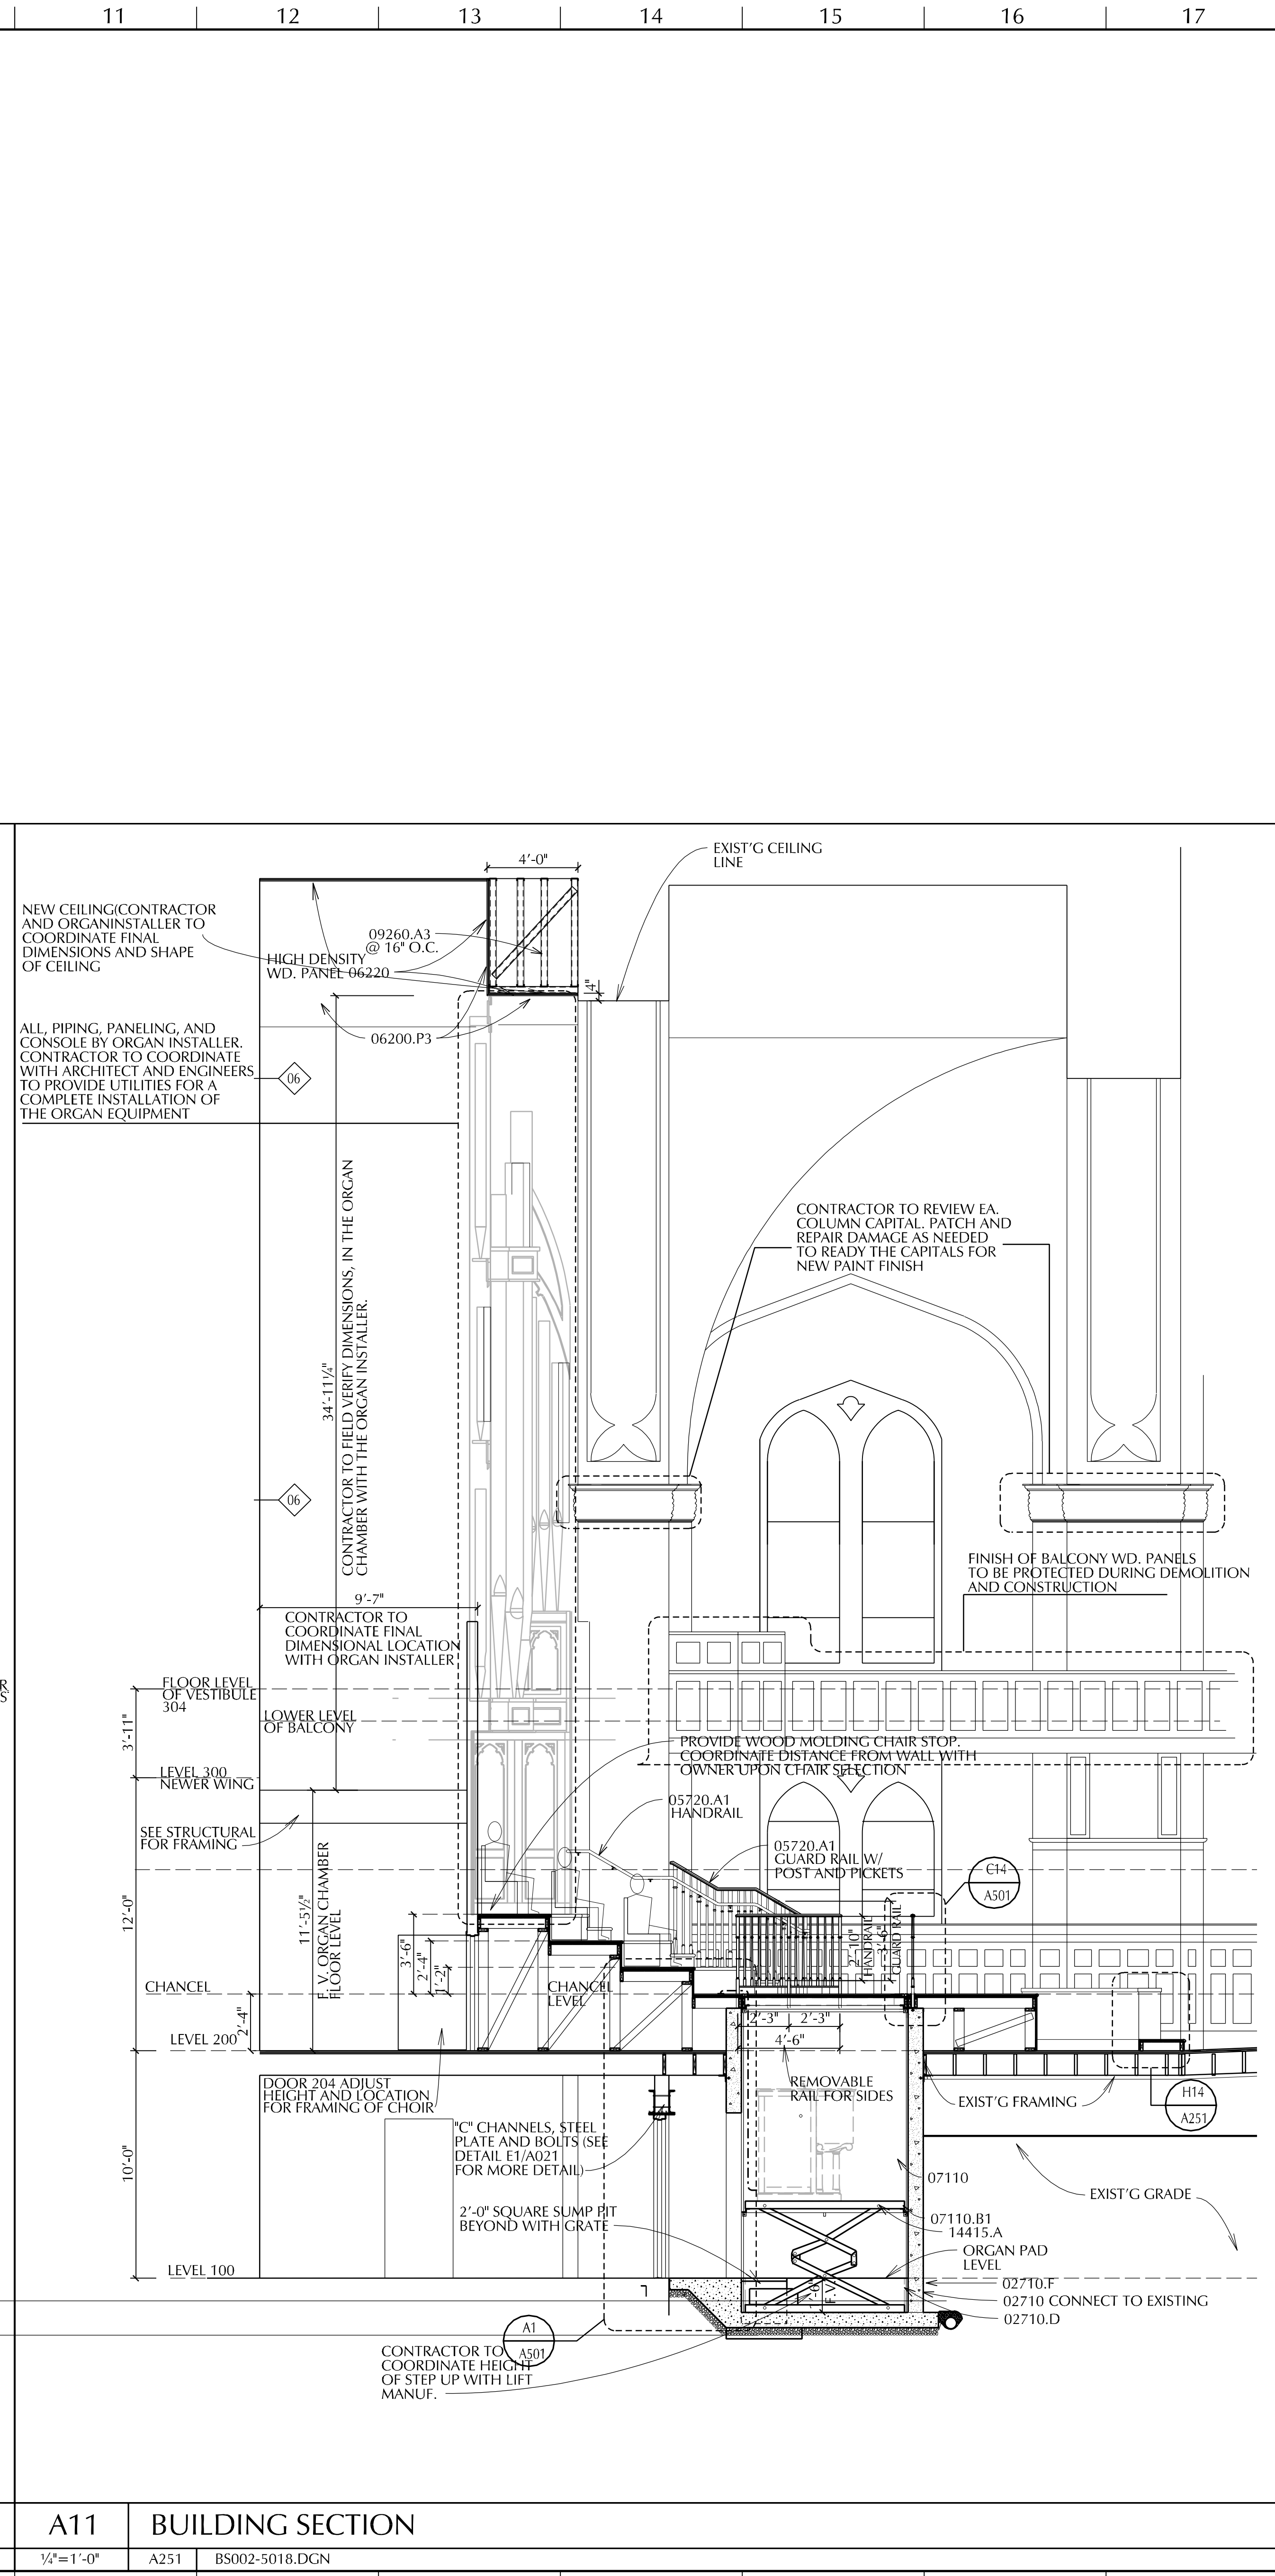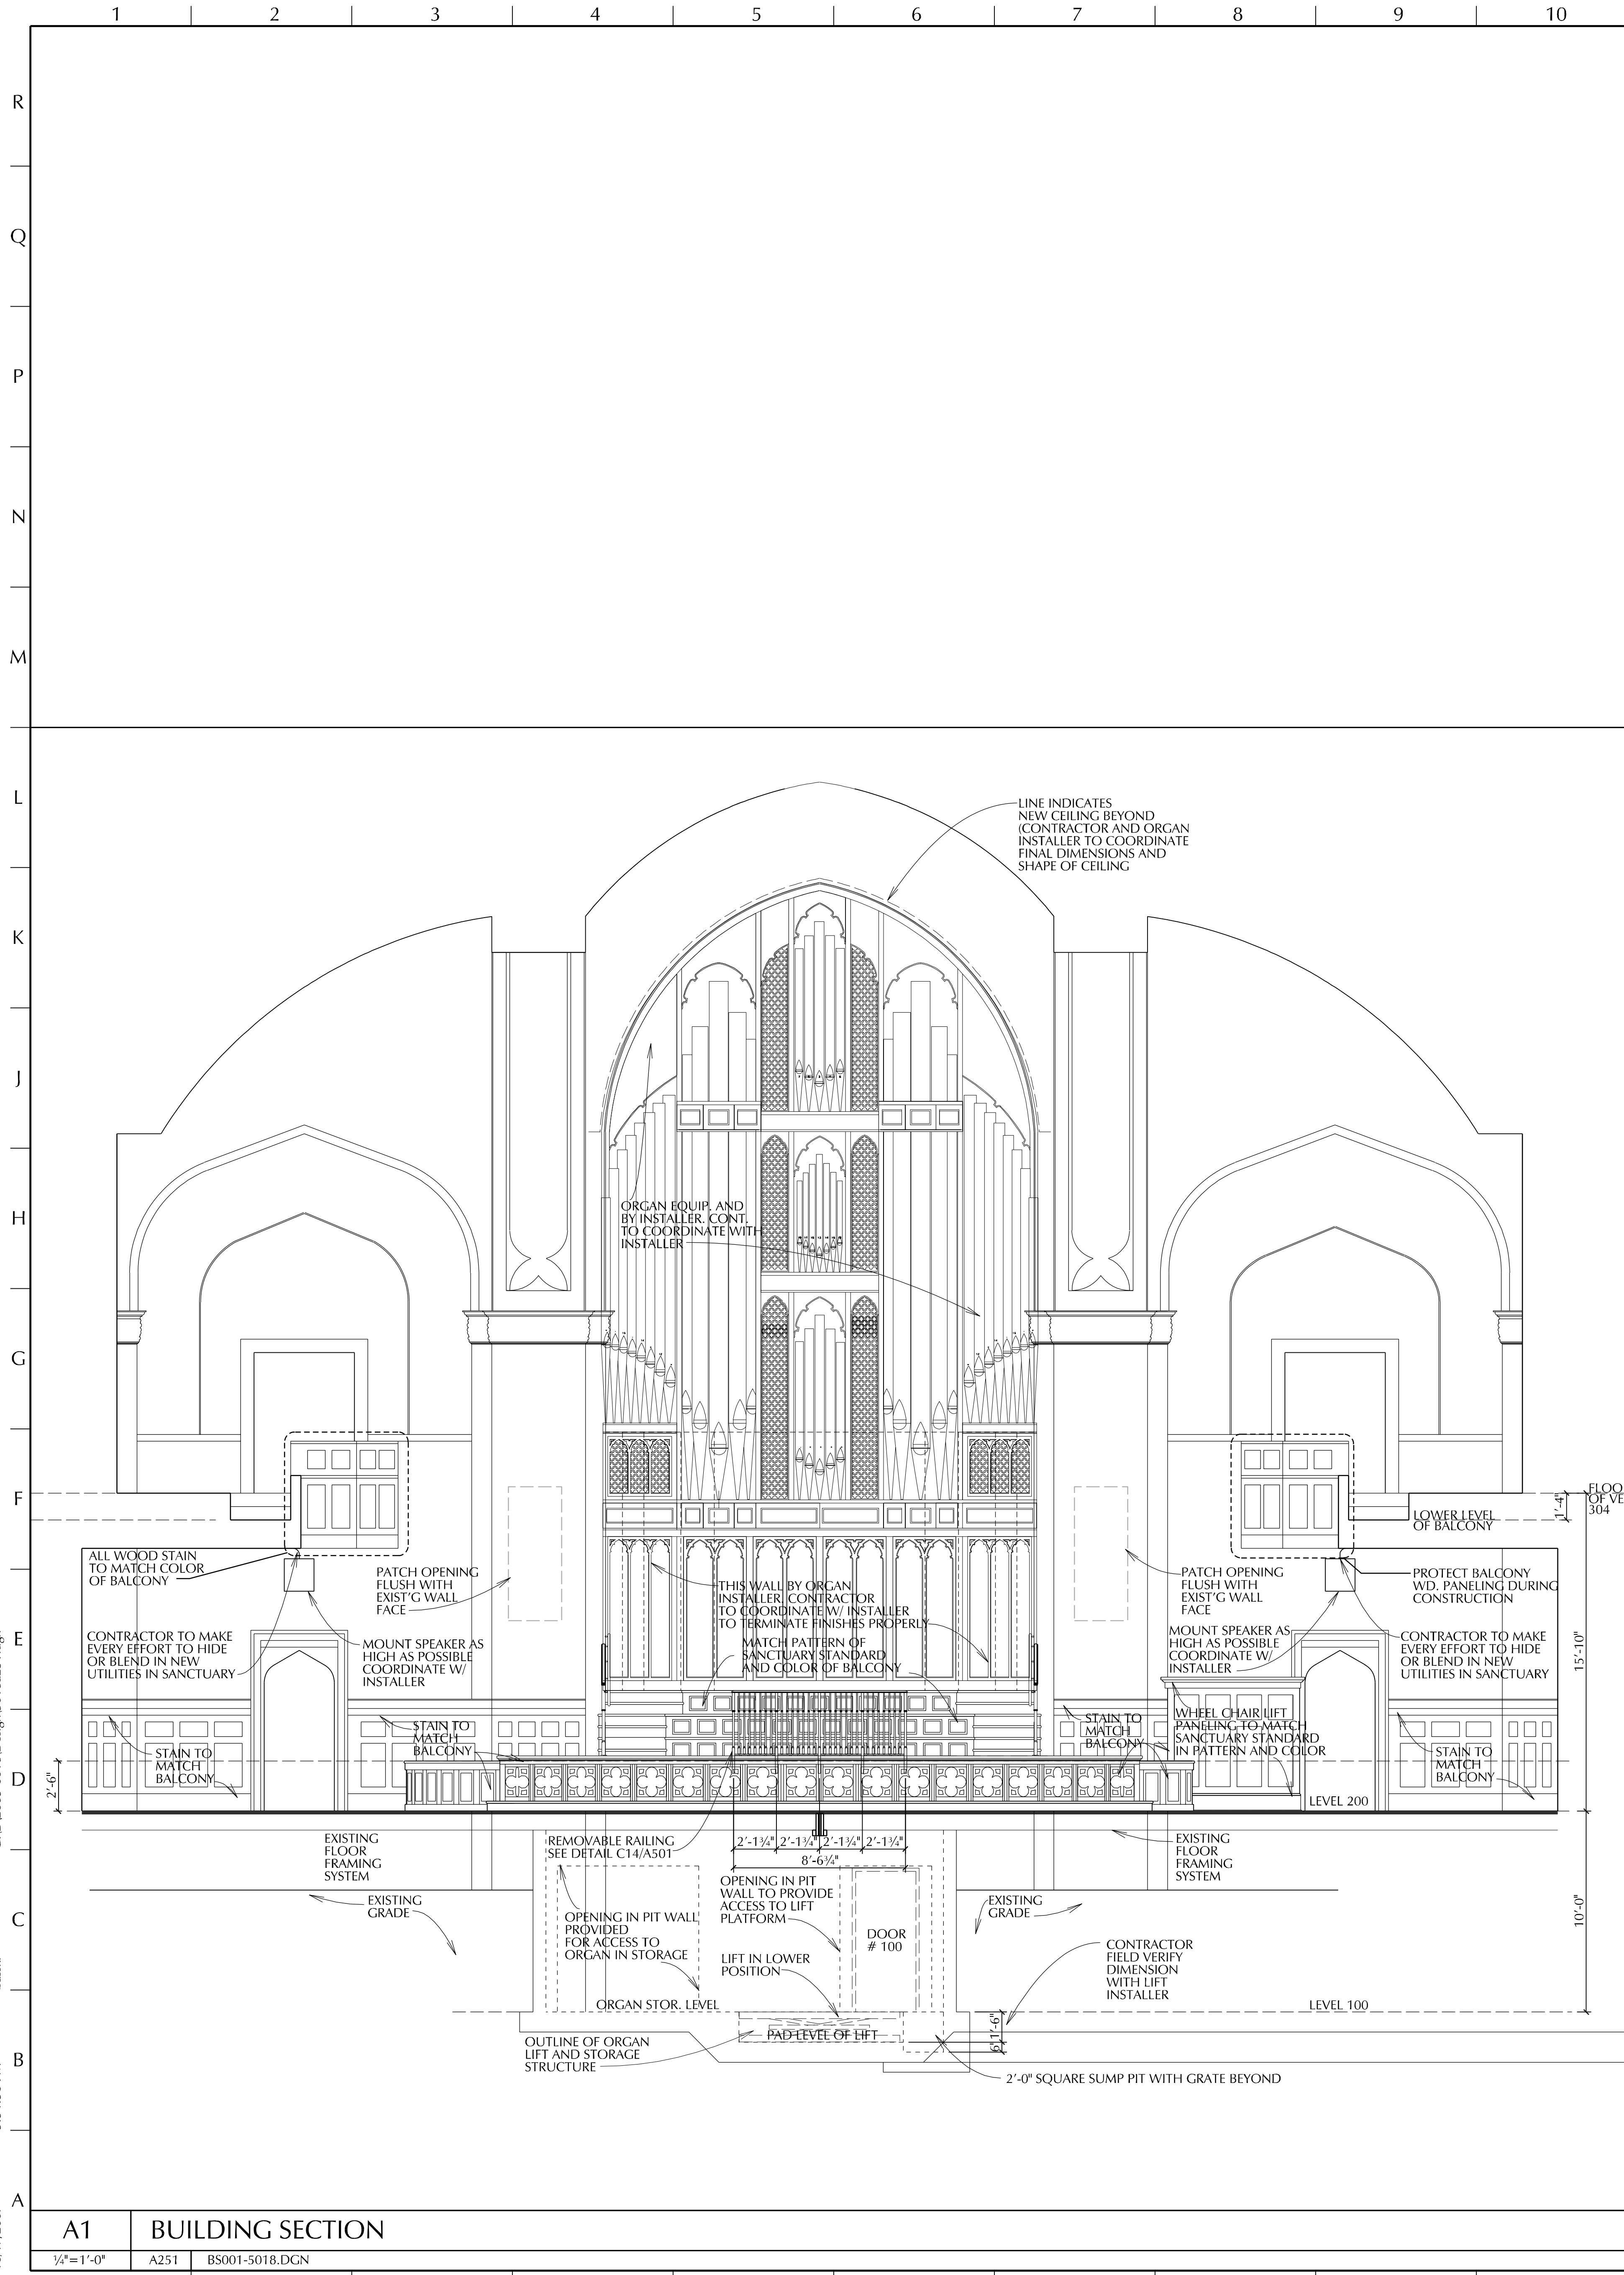

MATERIALS KEYING	
DIVISION 2: SITE WORK 02710 FOUNDATION DRAINAGE 02710.D DRAINAGE FILL 02710.F DRAINAGE FABRIC	
DIVISION 5: METALS 05720 ORNAMENTAL HANDRAILS AND RAILS 05720.A1 ORNAMENTAL HANDRAIL TYPE 1	
DIVISION 6: WOOD AND PLASTICS 06200 FINISH CARPENTRY 06200.P3 MDO PANEL 5/8" 06220 MILLWORK CABINETRY 06220 MILLWORK CABINETRY	
DIVISION 7: THERMAL AND MOISTURE PROTECTION 07110 MEMBRANE WATERPROOFING 07110.B1 MEMBRANE WATERPROOFING 07110.B1 DRAINAGE BOARD (MIRADRAIN)	
DIVISION 9: FINISHES 09260 GYPSUM WALLBOARD SYSTEMS 09260.A3 STD. SERIES MTL. STUD - 3/8"	
DIVISION 14: CONVEYING SYSTEMS 14415 WHEELCHAIR LIFTS 14415.A WHEELCHAIR LIFT TYPE 1	

INTERIOR RENOVATION FOR  
**ATLANTA FIRST  
UNITED METHODIST CHURCH**  
360 PEACHTREE ST NE ATLANTA, GA 30308

KEY PLAN	
PROJECT NO: 2005-0018	
CAD FILE NAME: ...01Ba251.dgn	
DRAWING NUMBER <b>A251</b> OF	






















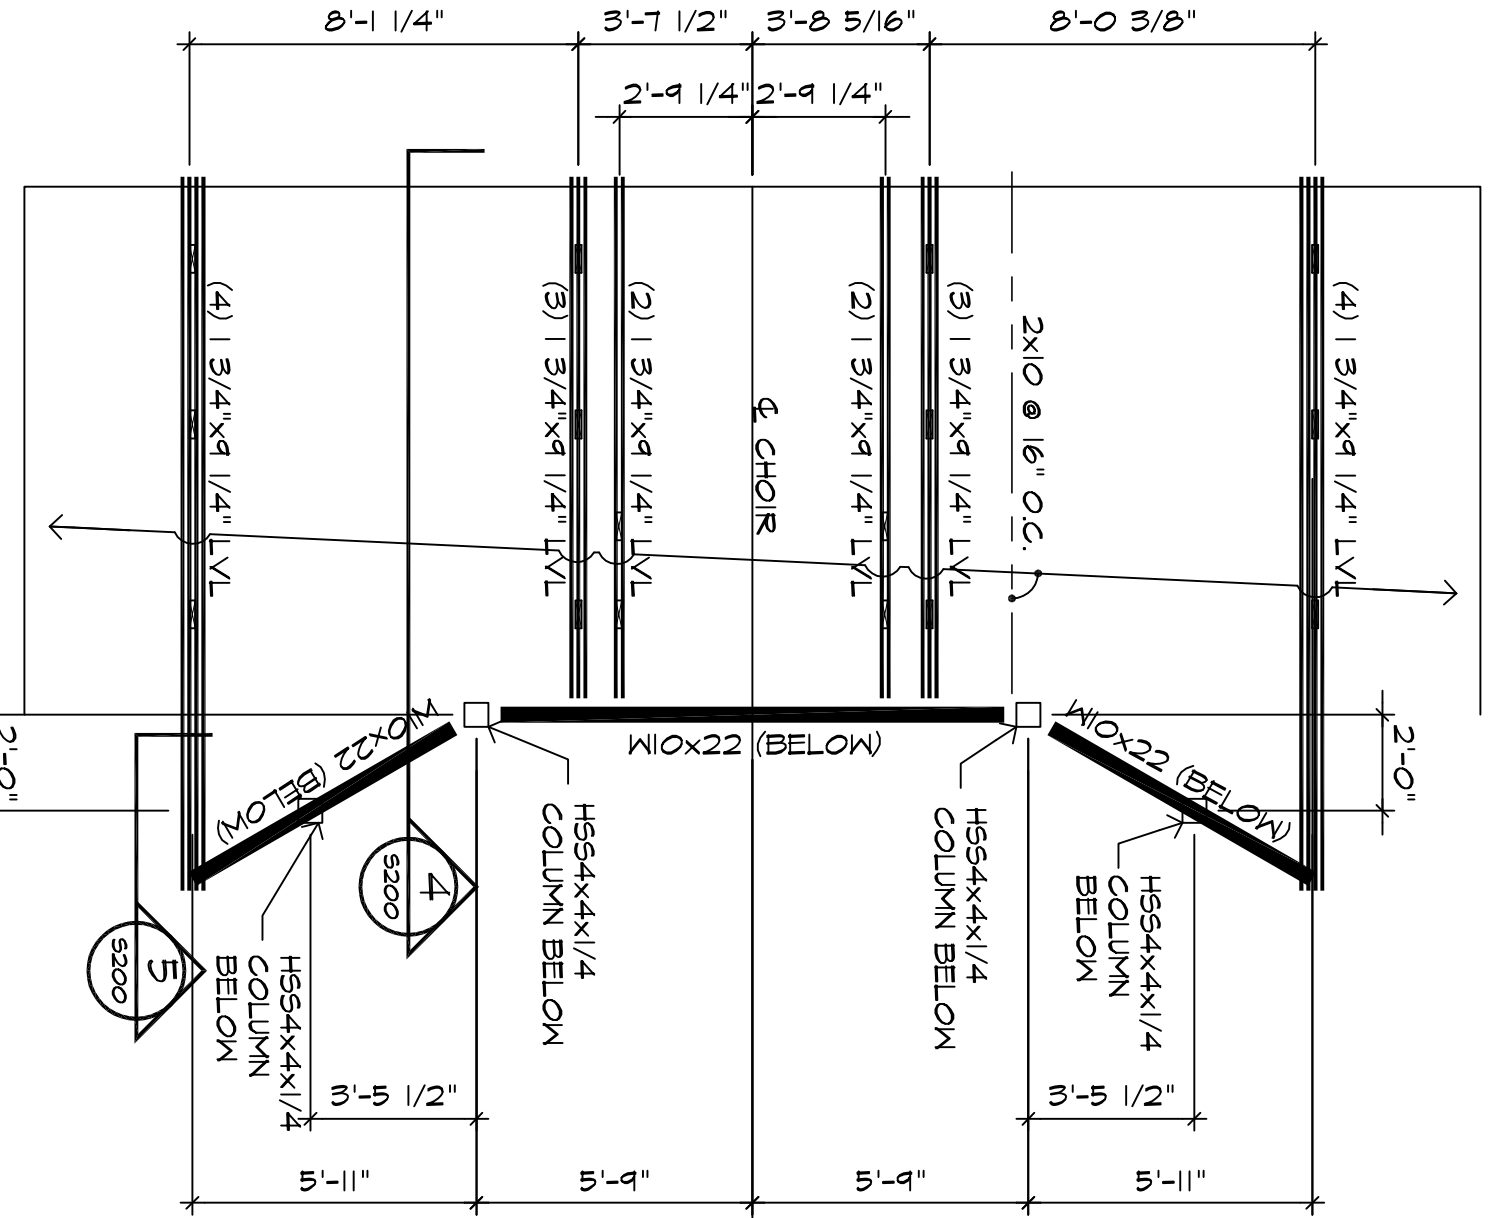


2 ORGAN FLOOR FRAMING PLAN  
SCALE: 1/4" = 1'-0"  
NOTE: LOCATE LVL BEAMS TO FALL BELOW ORGAN SUPPORTS. VERIFY WITH STRUCTURAL ENGINEER.  
PROVIDE 4x8 POSTS BELOW QUADRUPLE LVL BEAMS AND POSTS BELOW TRIPLE LVL BEAMS AND 4x4 POSTS BELOW DOUBLE LVL BEAMS.

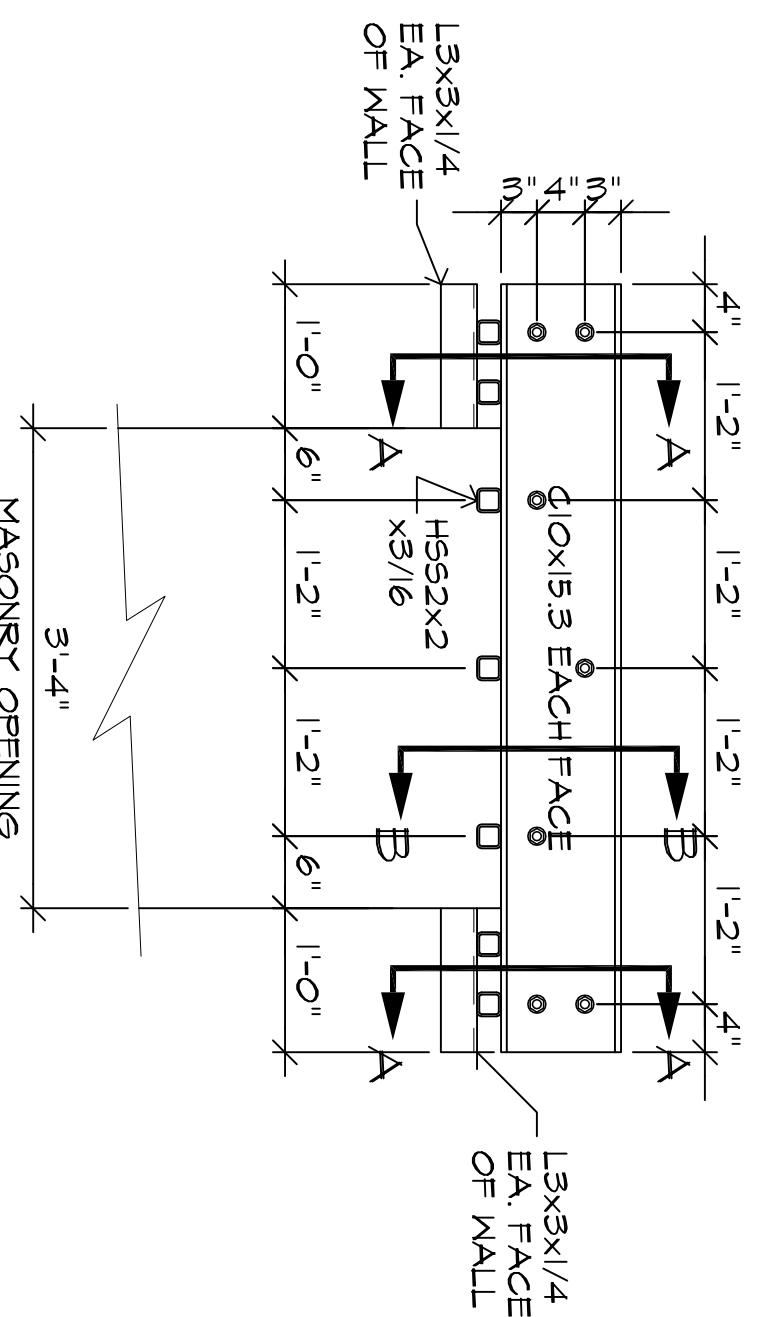


1 HEADER ELEVATION  
SCALE: 3/4" = 1'-0"

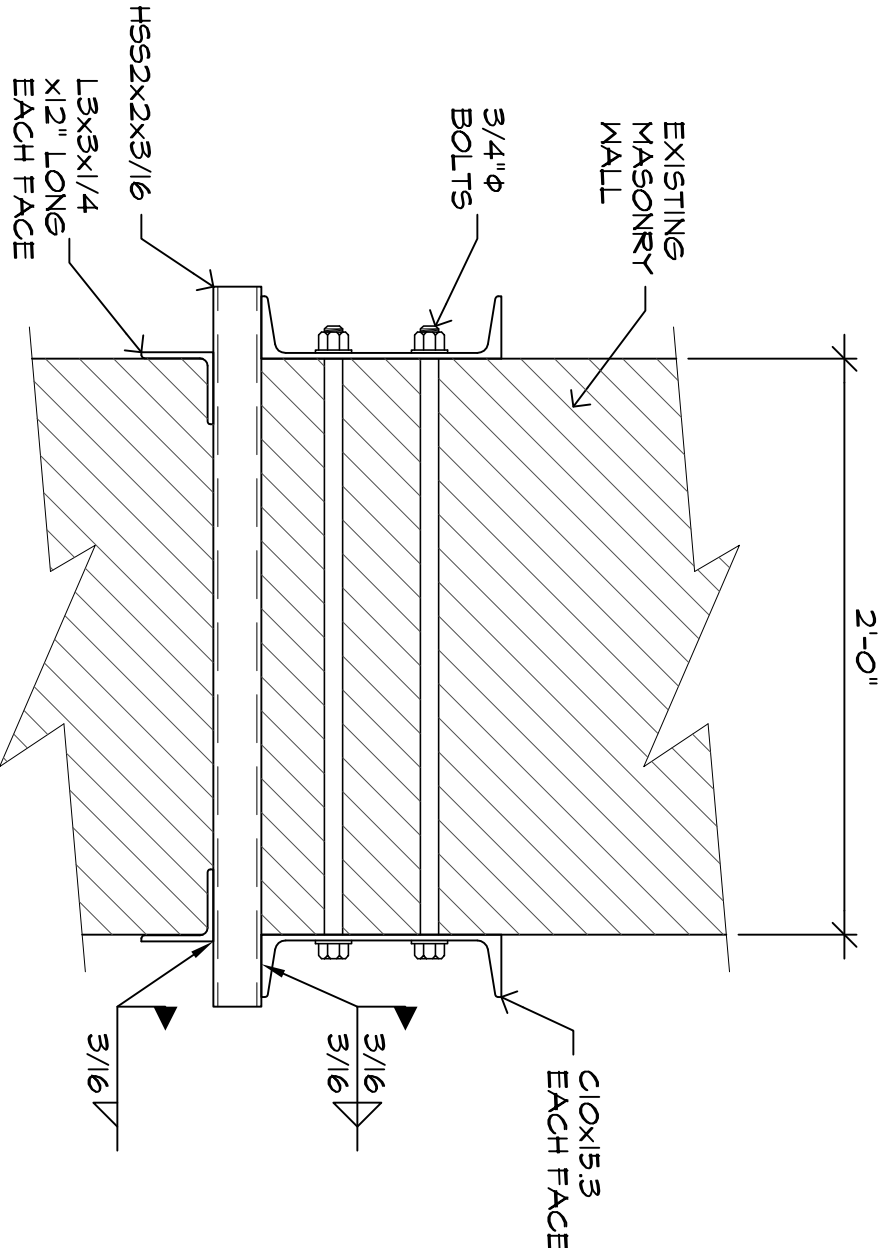

A SECTION  
SCALE: 1/2" = 1'-0"  
NOTE: CUT SLITS IN EXISTING MASONRY TO INSERT L3x3x1/4 BOLTS TO SET H65x2x3/16 WITH FULL BEARING ON L3x3x1/4 BEAR CLOS ON H65x2x3/16 AND WELD AS SHOWN.

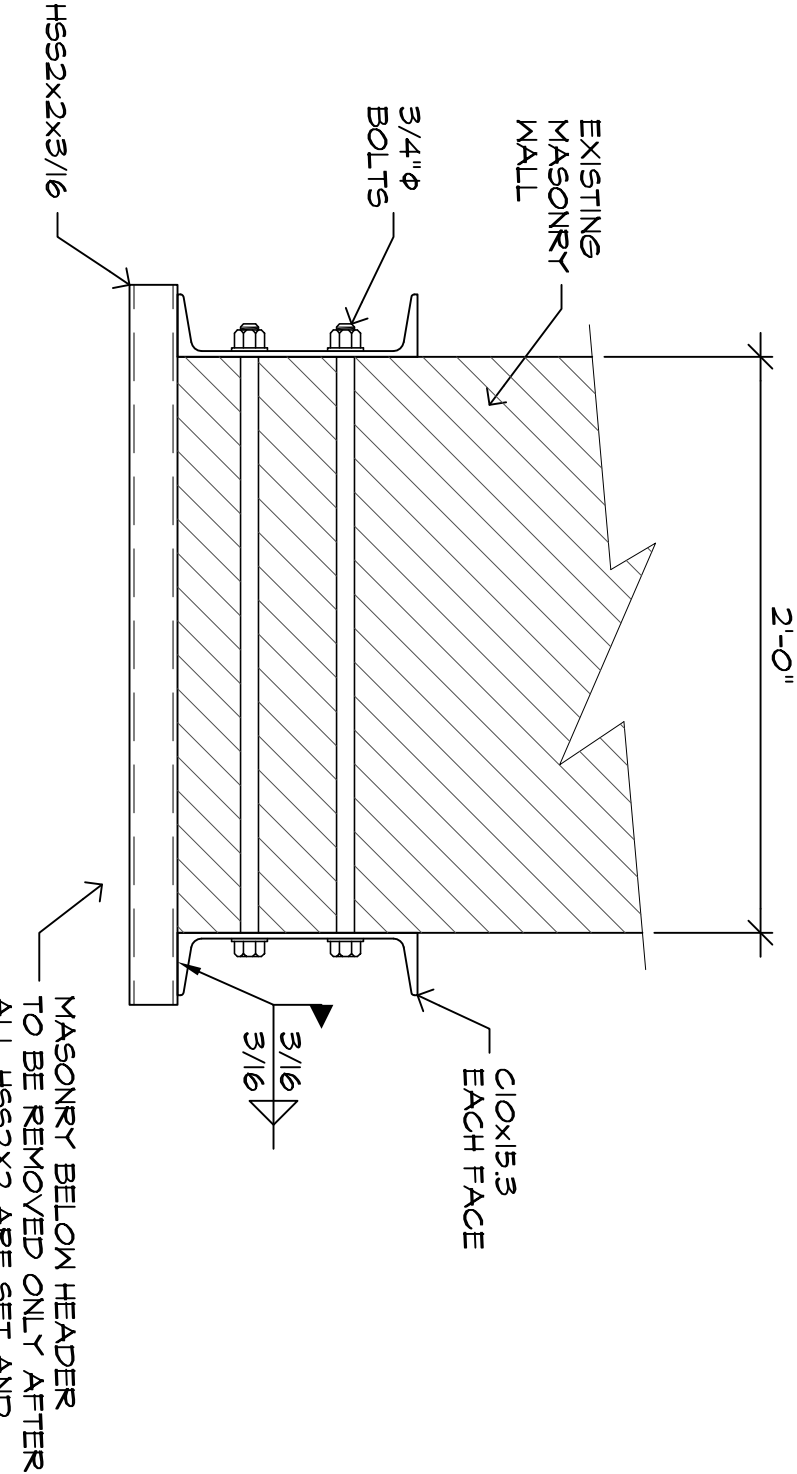

B SECTION  
SCALE: 1/2" = 1'-0"  
NOTE: REMOVE EXISTING MASONRY TO SET 3/4x3x3/16 BOLTS IN MASONRY AS EACH CONTACT AS H65x2x3/16. MAINTAIN AS MUCH CONTACT AS POSSIBLE. VERIFY MASONRY DOES NOT HAVE GOOD CONTACT WITH THE TIEBARS. PROVIDE WORKMAN BETWEEN THE SPACERS FOR TIE CONTACT.

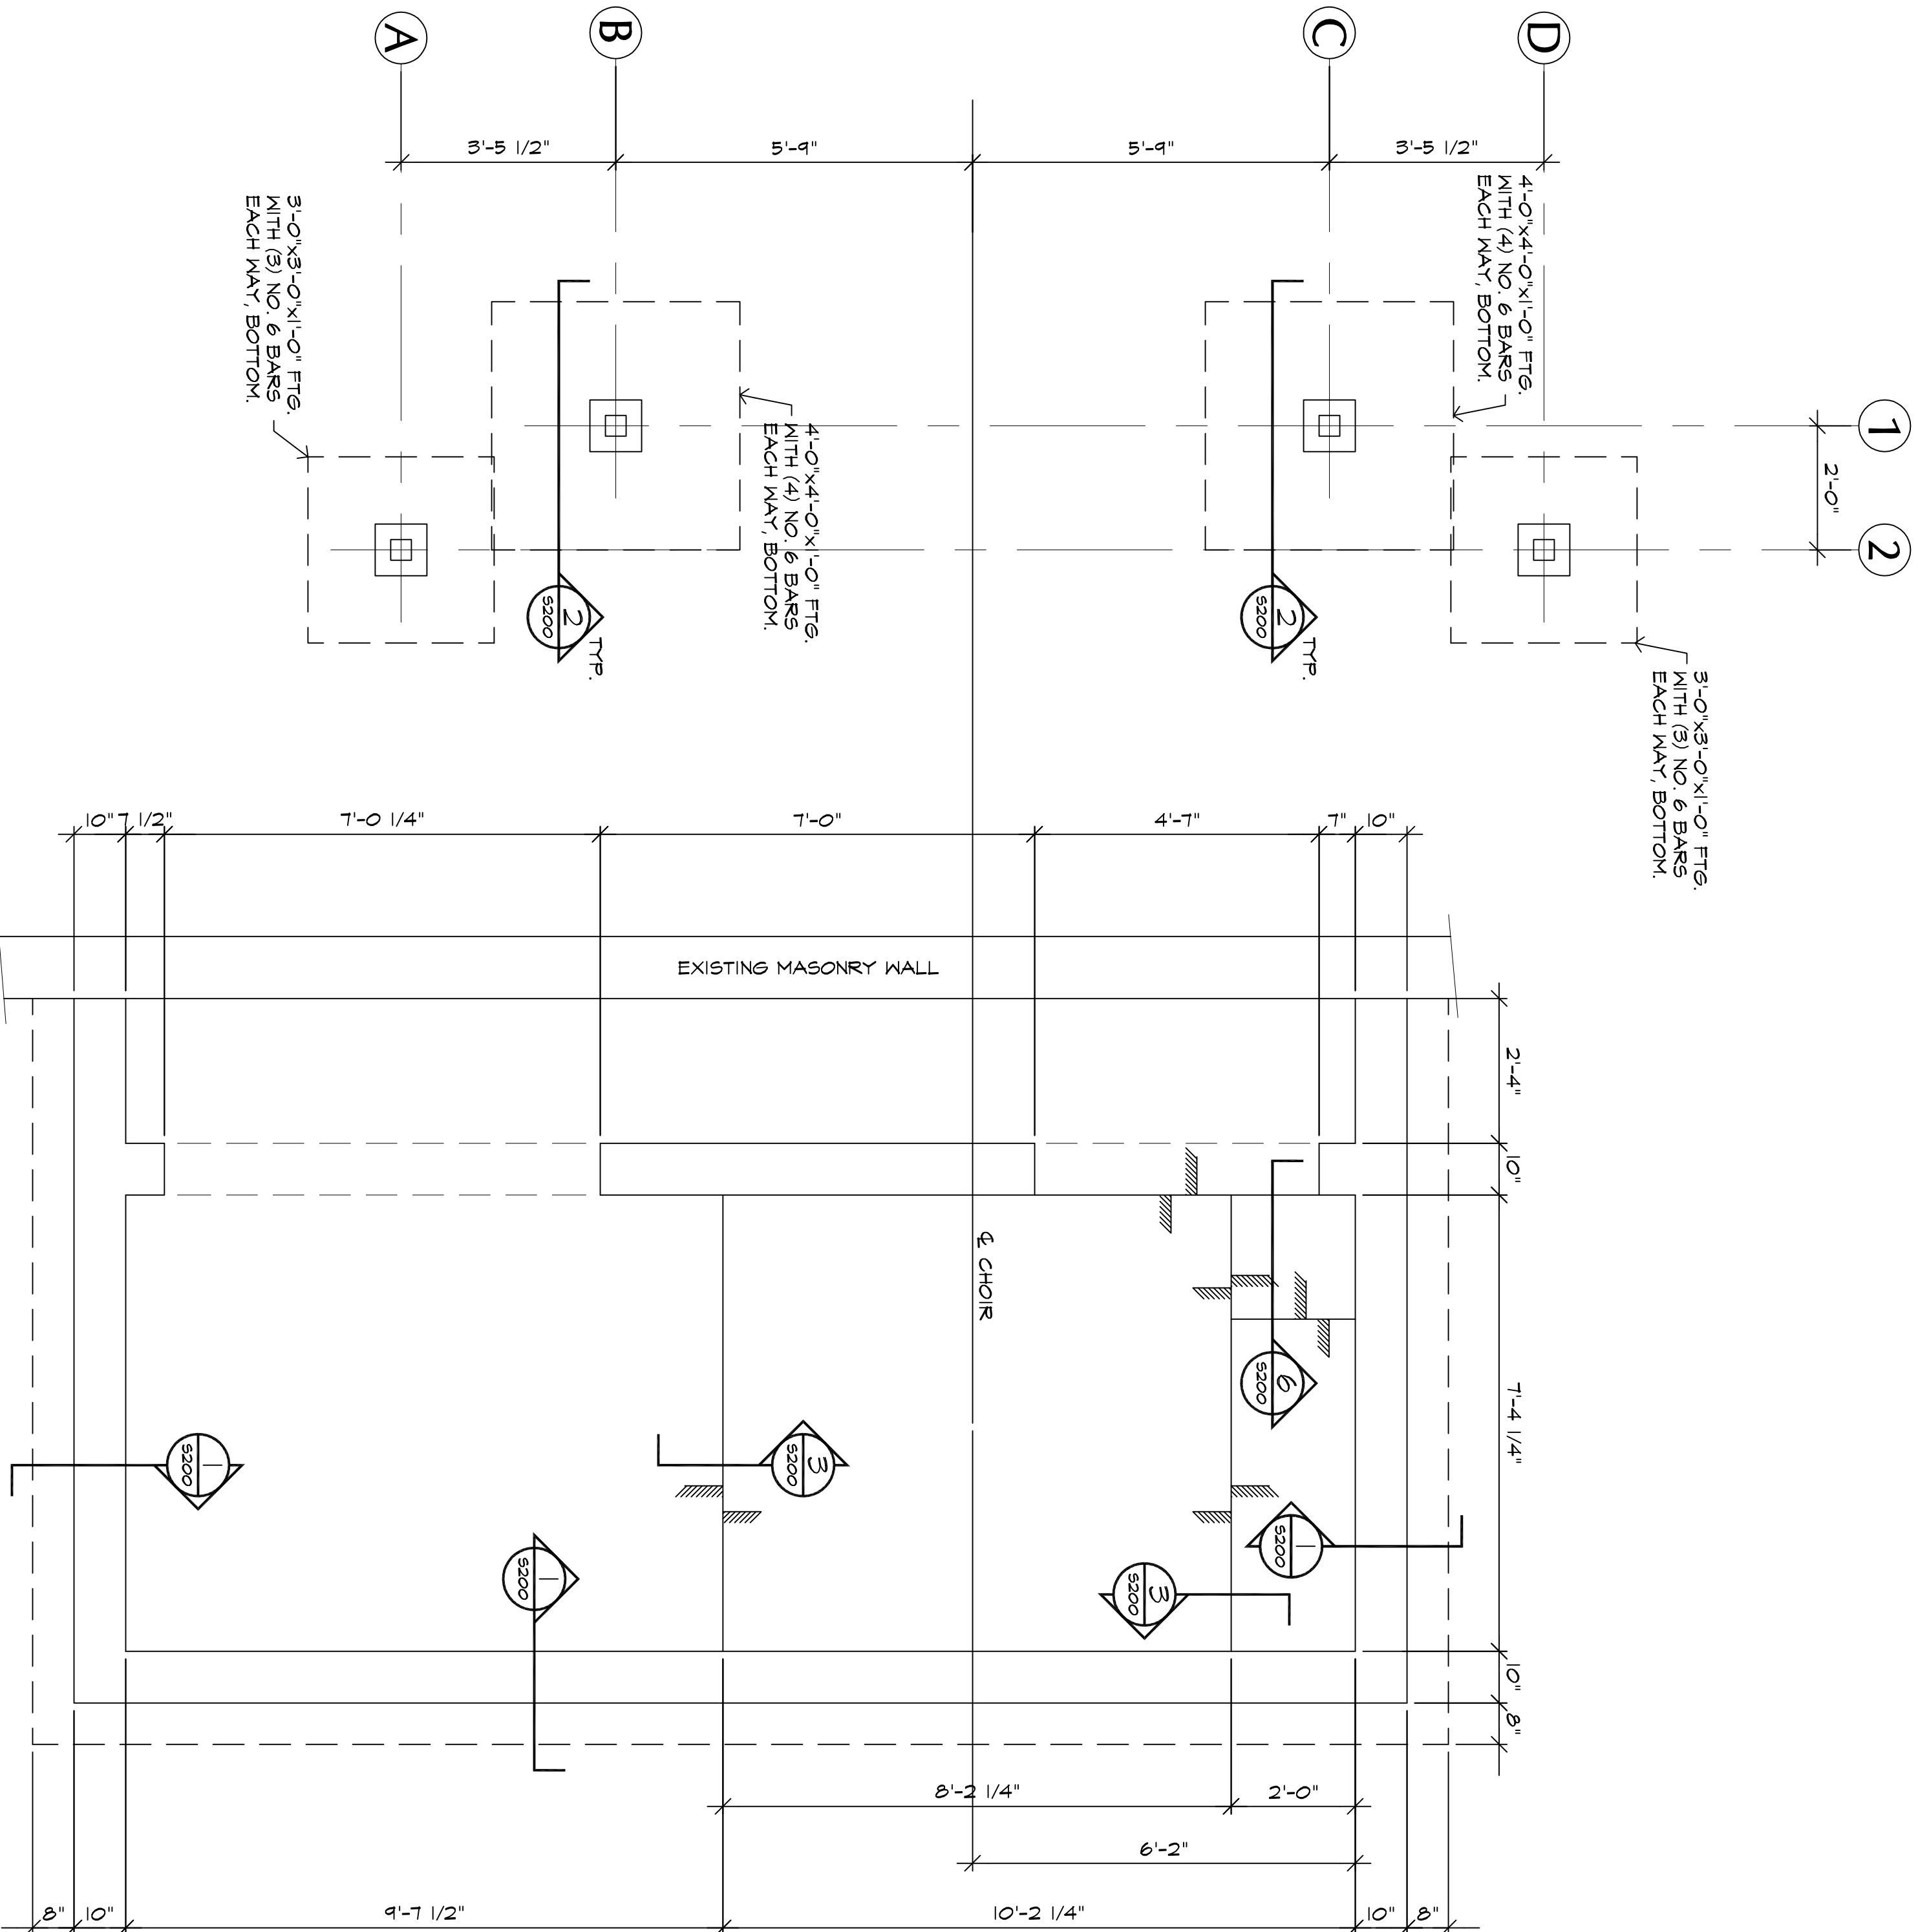

1 FOUNDATION PLAN  
SCALE: 1/2" = 1'-0"



ARCHITECTURE  
ENGINEERING  
INTERIOR DESIGN  
CONSTRUCTION SERVICES

675 Tower Road  
Atlanta, GA 30364-6938  
Tel: 770-444-0060  
Fax: 770-444-0060  
www.odhipartners.com

INTERIOR RENOVATION FOR  
ATLANTA FIRST  
UNITED METHODIST CHURCH  
360 PEACHTREE ST NE ATLANTA, GEORGIA 30308

10/17/2007  
SHEET FRAMINGS

PROJECT NO:  
2005-0018  
CADD FILE: 04/06/2006

COPYRIGHT © 2005 by Norton, Schmidt & Warden, LLP. All rights reserved. No portion of this drawing may be used or reproduced without written permission of Norton, Schmidt & Warden, LLP.

Norton, Schmidt & Warden

4682 Lawrenceville Hwy.  
Suite 100  
Lawrenceville, GA 30046  
Tel: (770) 951-6944  
Fax: (770) 951-6978  
E-mail: nsw@nortonshmidt.net


RELEASD FOR CONSTRUCTION  
SHEET TITLE  
FOUNDATION AND  
FRAMING PLANS

PRINT DATE: October 17, 2007


DRAWING NUMBER  
S100  
OR






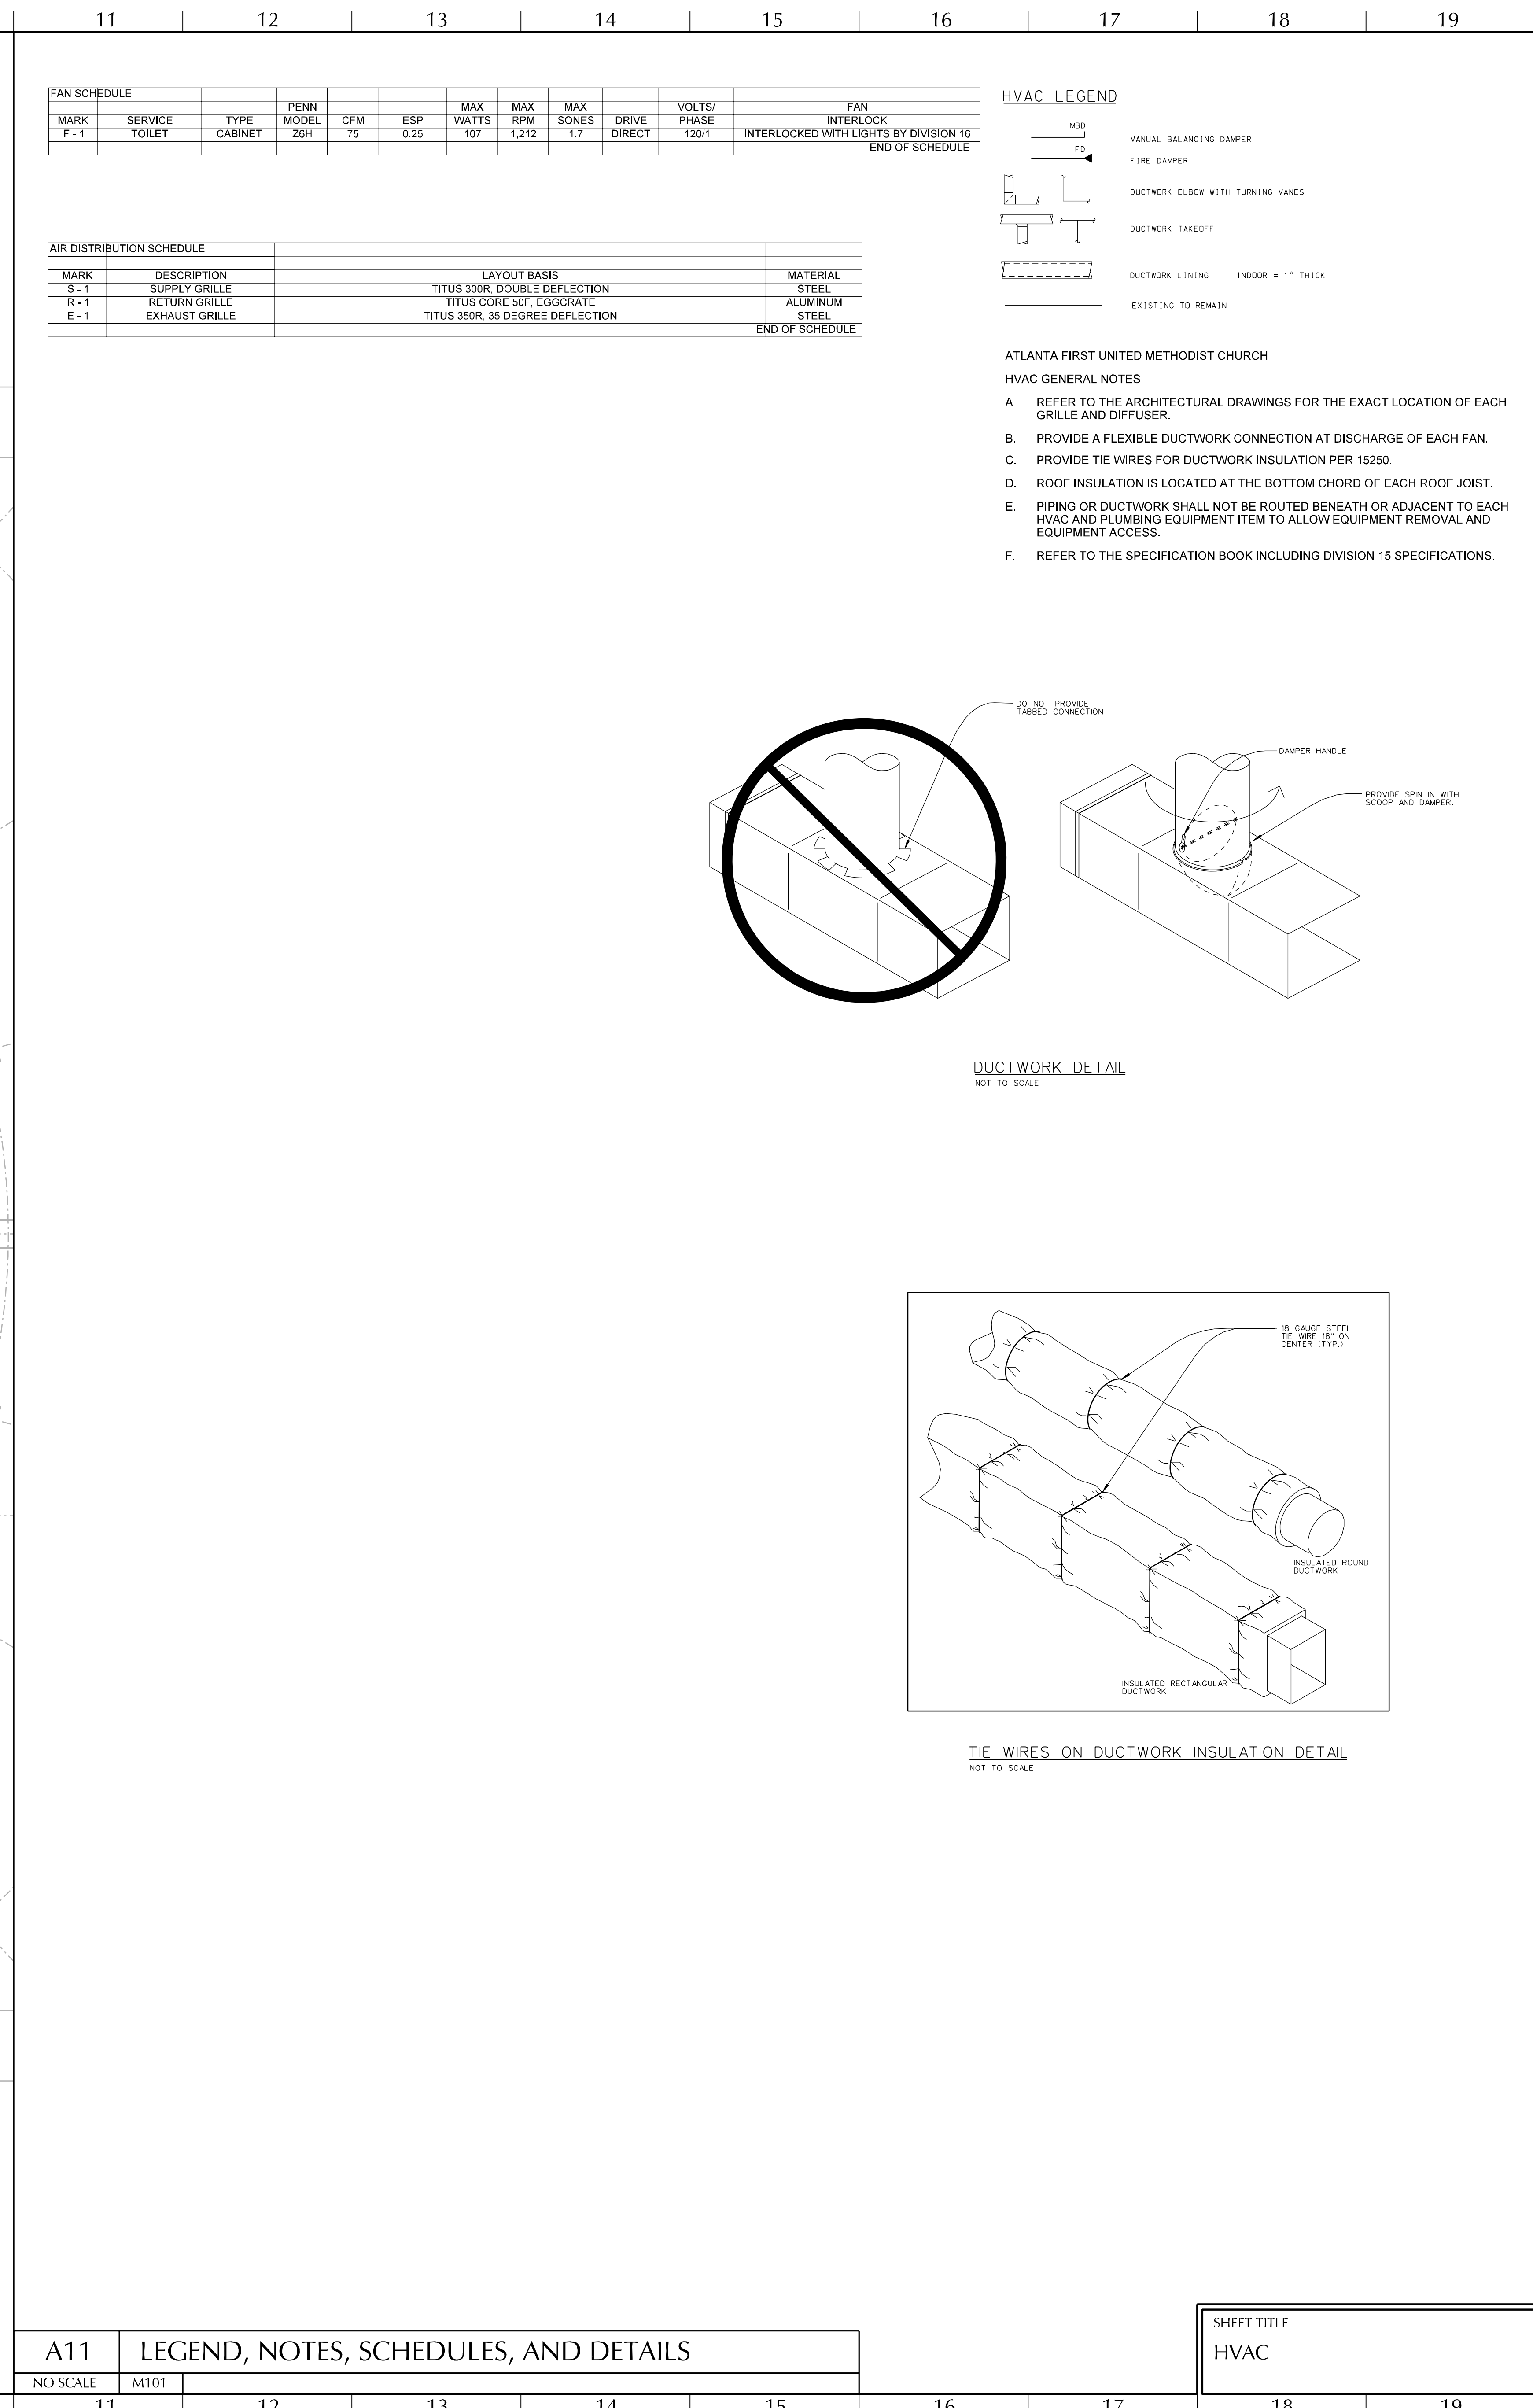



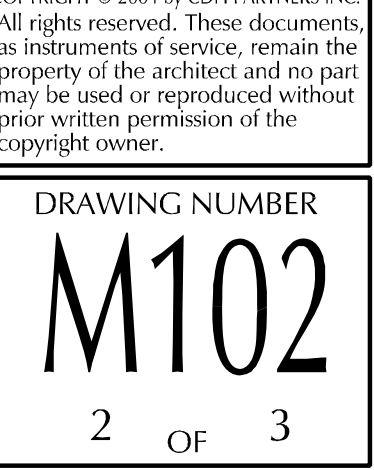

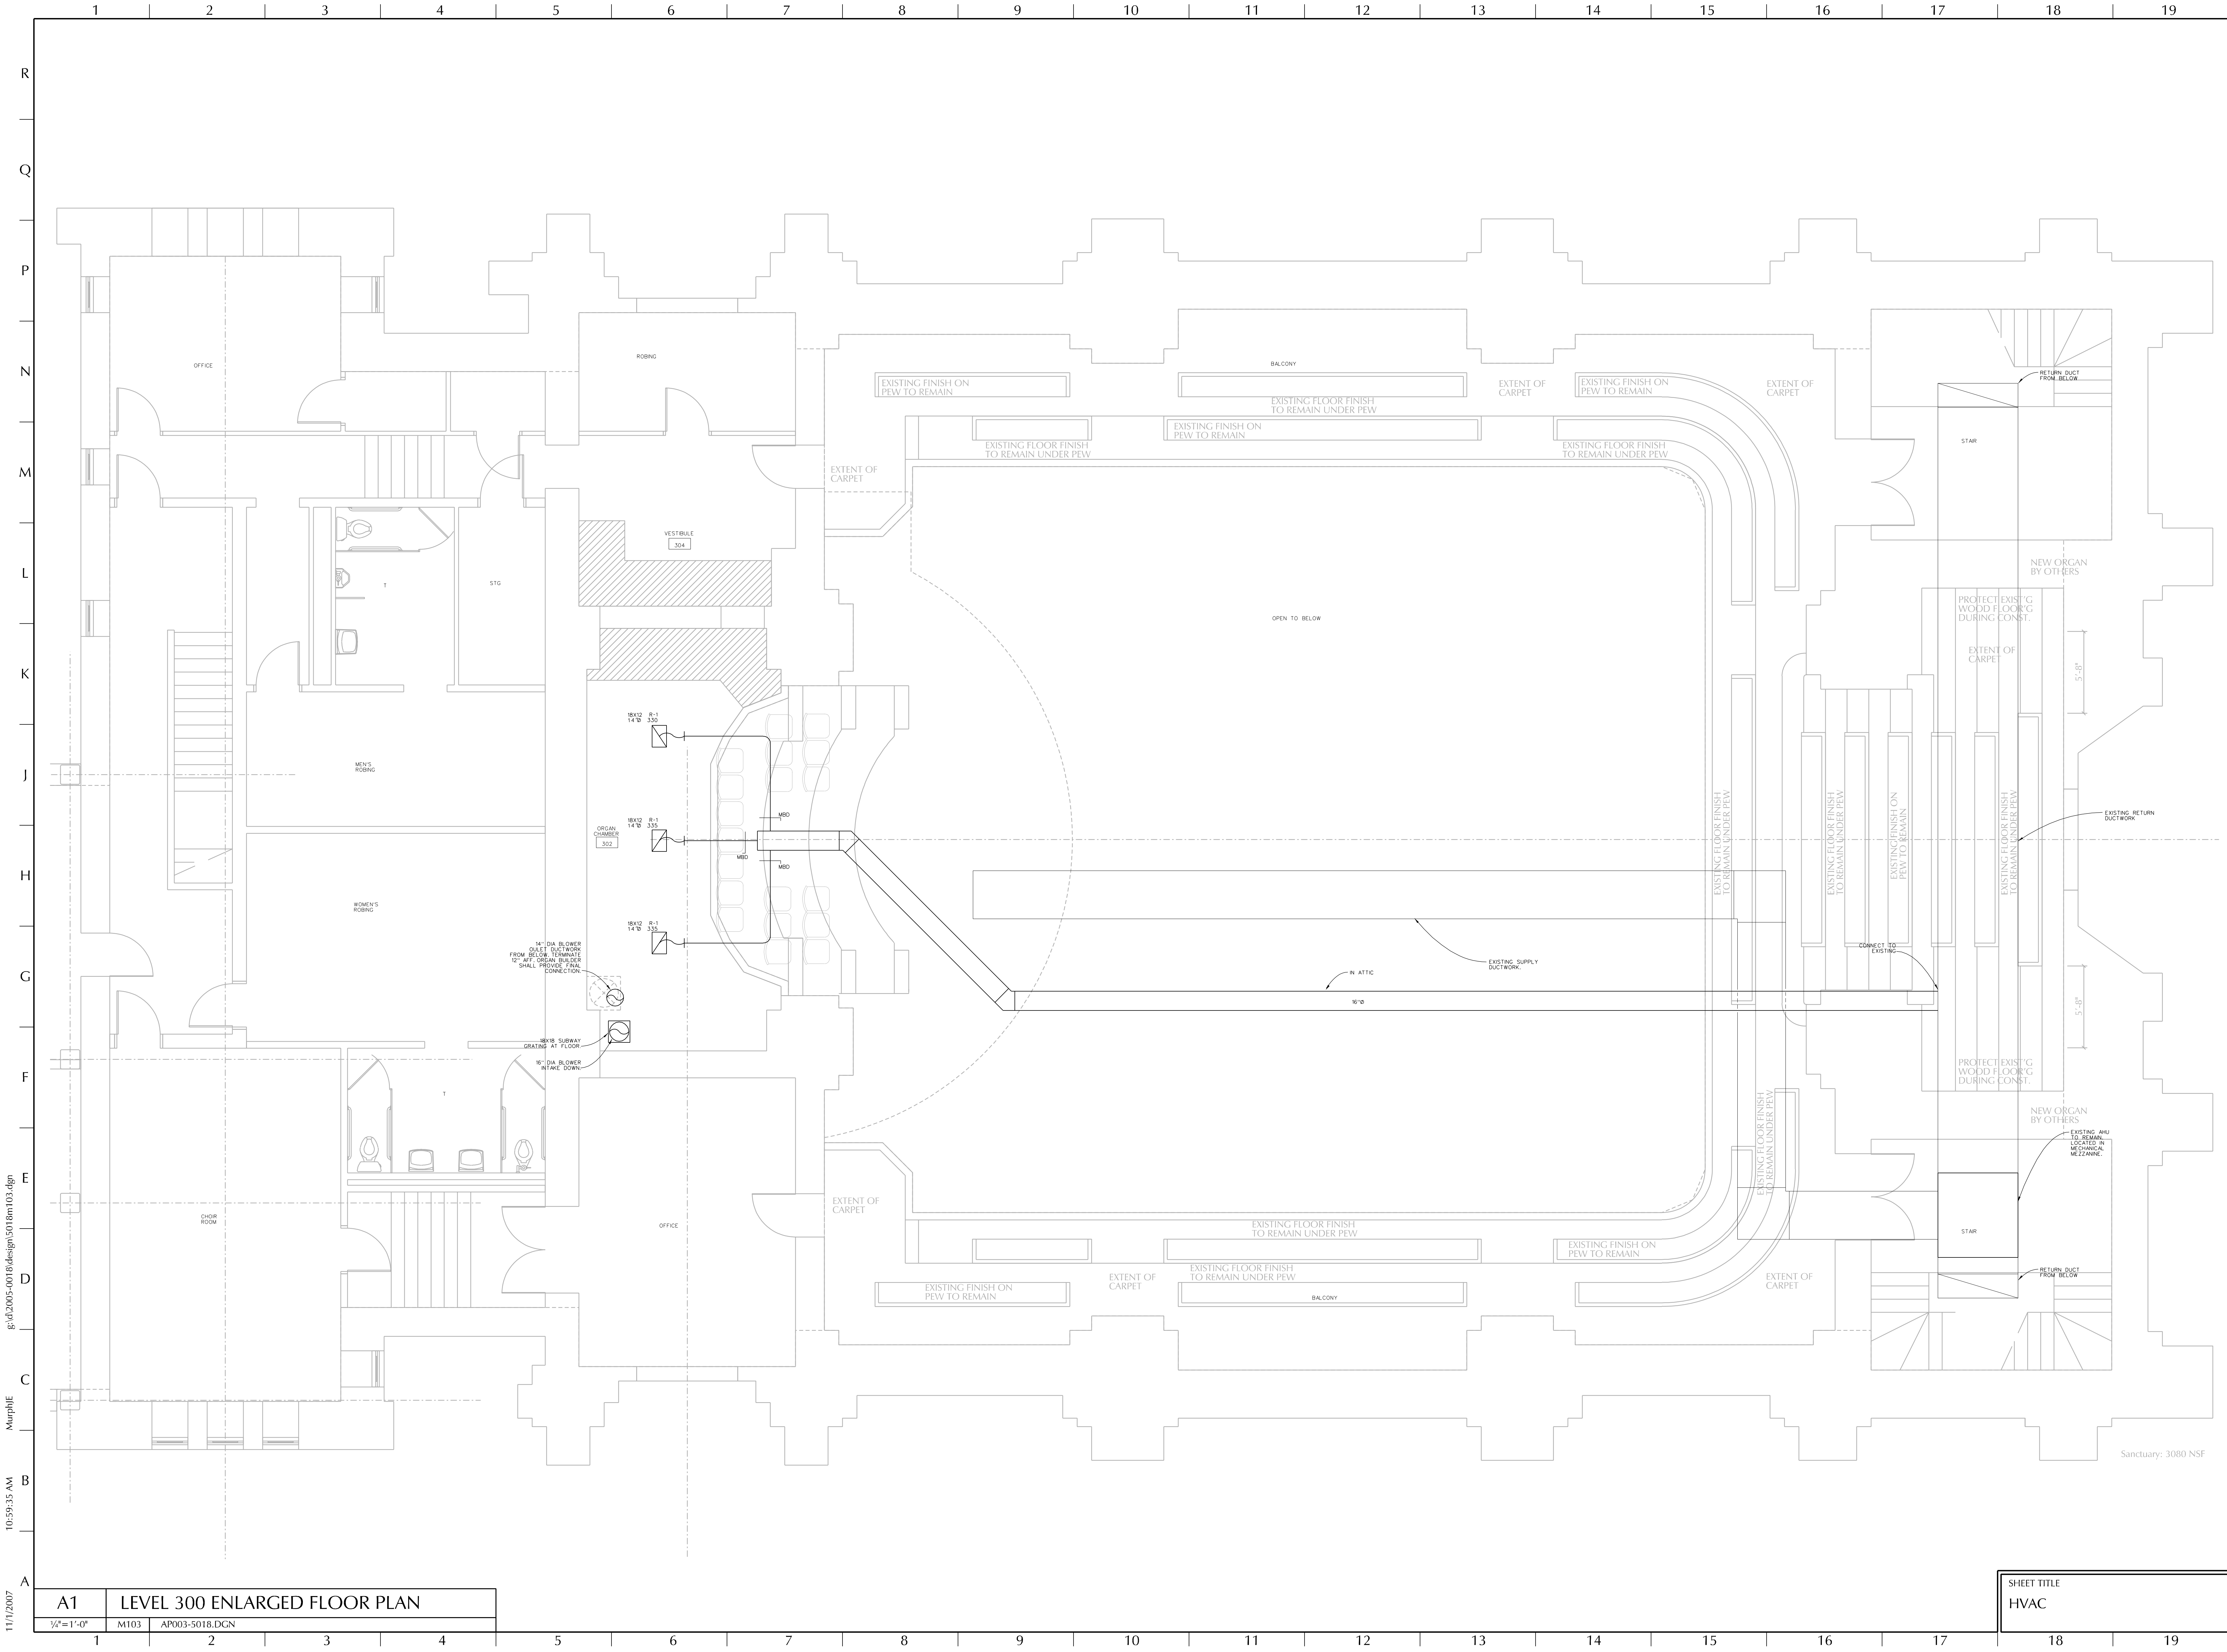

11/1/2007 10:59:35 AM MurphIE g:\d\2005-0018\design\5018m103.dgn

A1	LEVEL 300 ENLARGED FLOOR PLAN	
1/4"=1'-0"	M103	AP003-5018.DGN

SHEET TITLE
HVAC

CDHPARTNERS

ARCHITECTURE  
ENGINEERING  
INTERIOR DESIGN  
CONSTRUCTION SERVICES

675 Tower Road  
Marietta, Ga 30060-6958  
Off: 770.423.0016  
Fax: 770.424.0260  
www.cdhparkers.com

GEORGIA  
REGISTERED  
PROFESSIONAL  
ENGINEER  
R. CARRILLO

INTERIOR RENOVATION FOR  
ATLANTA FIRST  
UNITED METHODIST CHURCH  
360 PEACHTREE ST NE ATLANTA, GA 30308

1004-2007  
AS BUILT DRAWINGS


 
PROJECT NO:  
2005-0018

CAD FILE NAME:  
...5018m103.dgn


COPYRIGHT © 2004 by CDH PARTNERS INC.  
All rights reserved. These documents,  
as instruments of service, remain the  
property of the architect and no part  
may be used or reproduced without  
prior written permission of the  
copyright owner.



DRAWING NUMBER  
M103  
3 OF 3

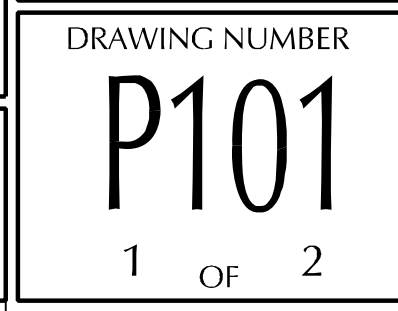

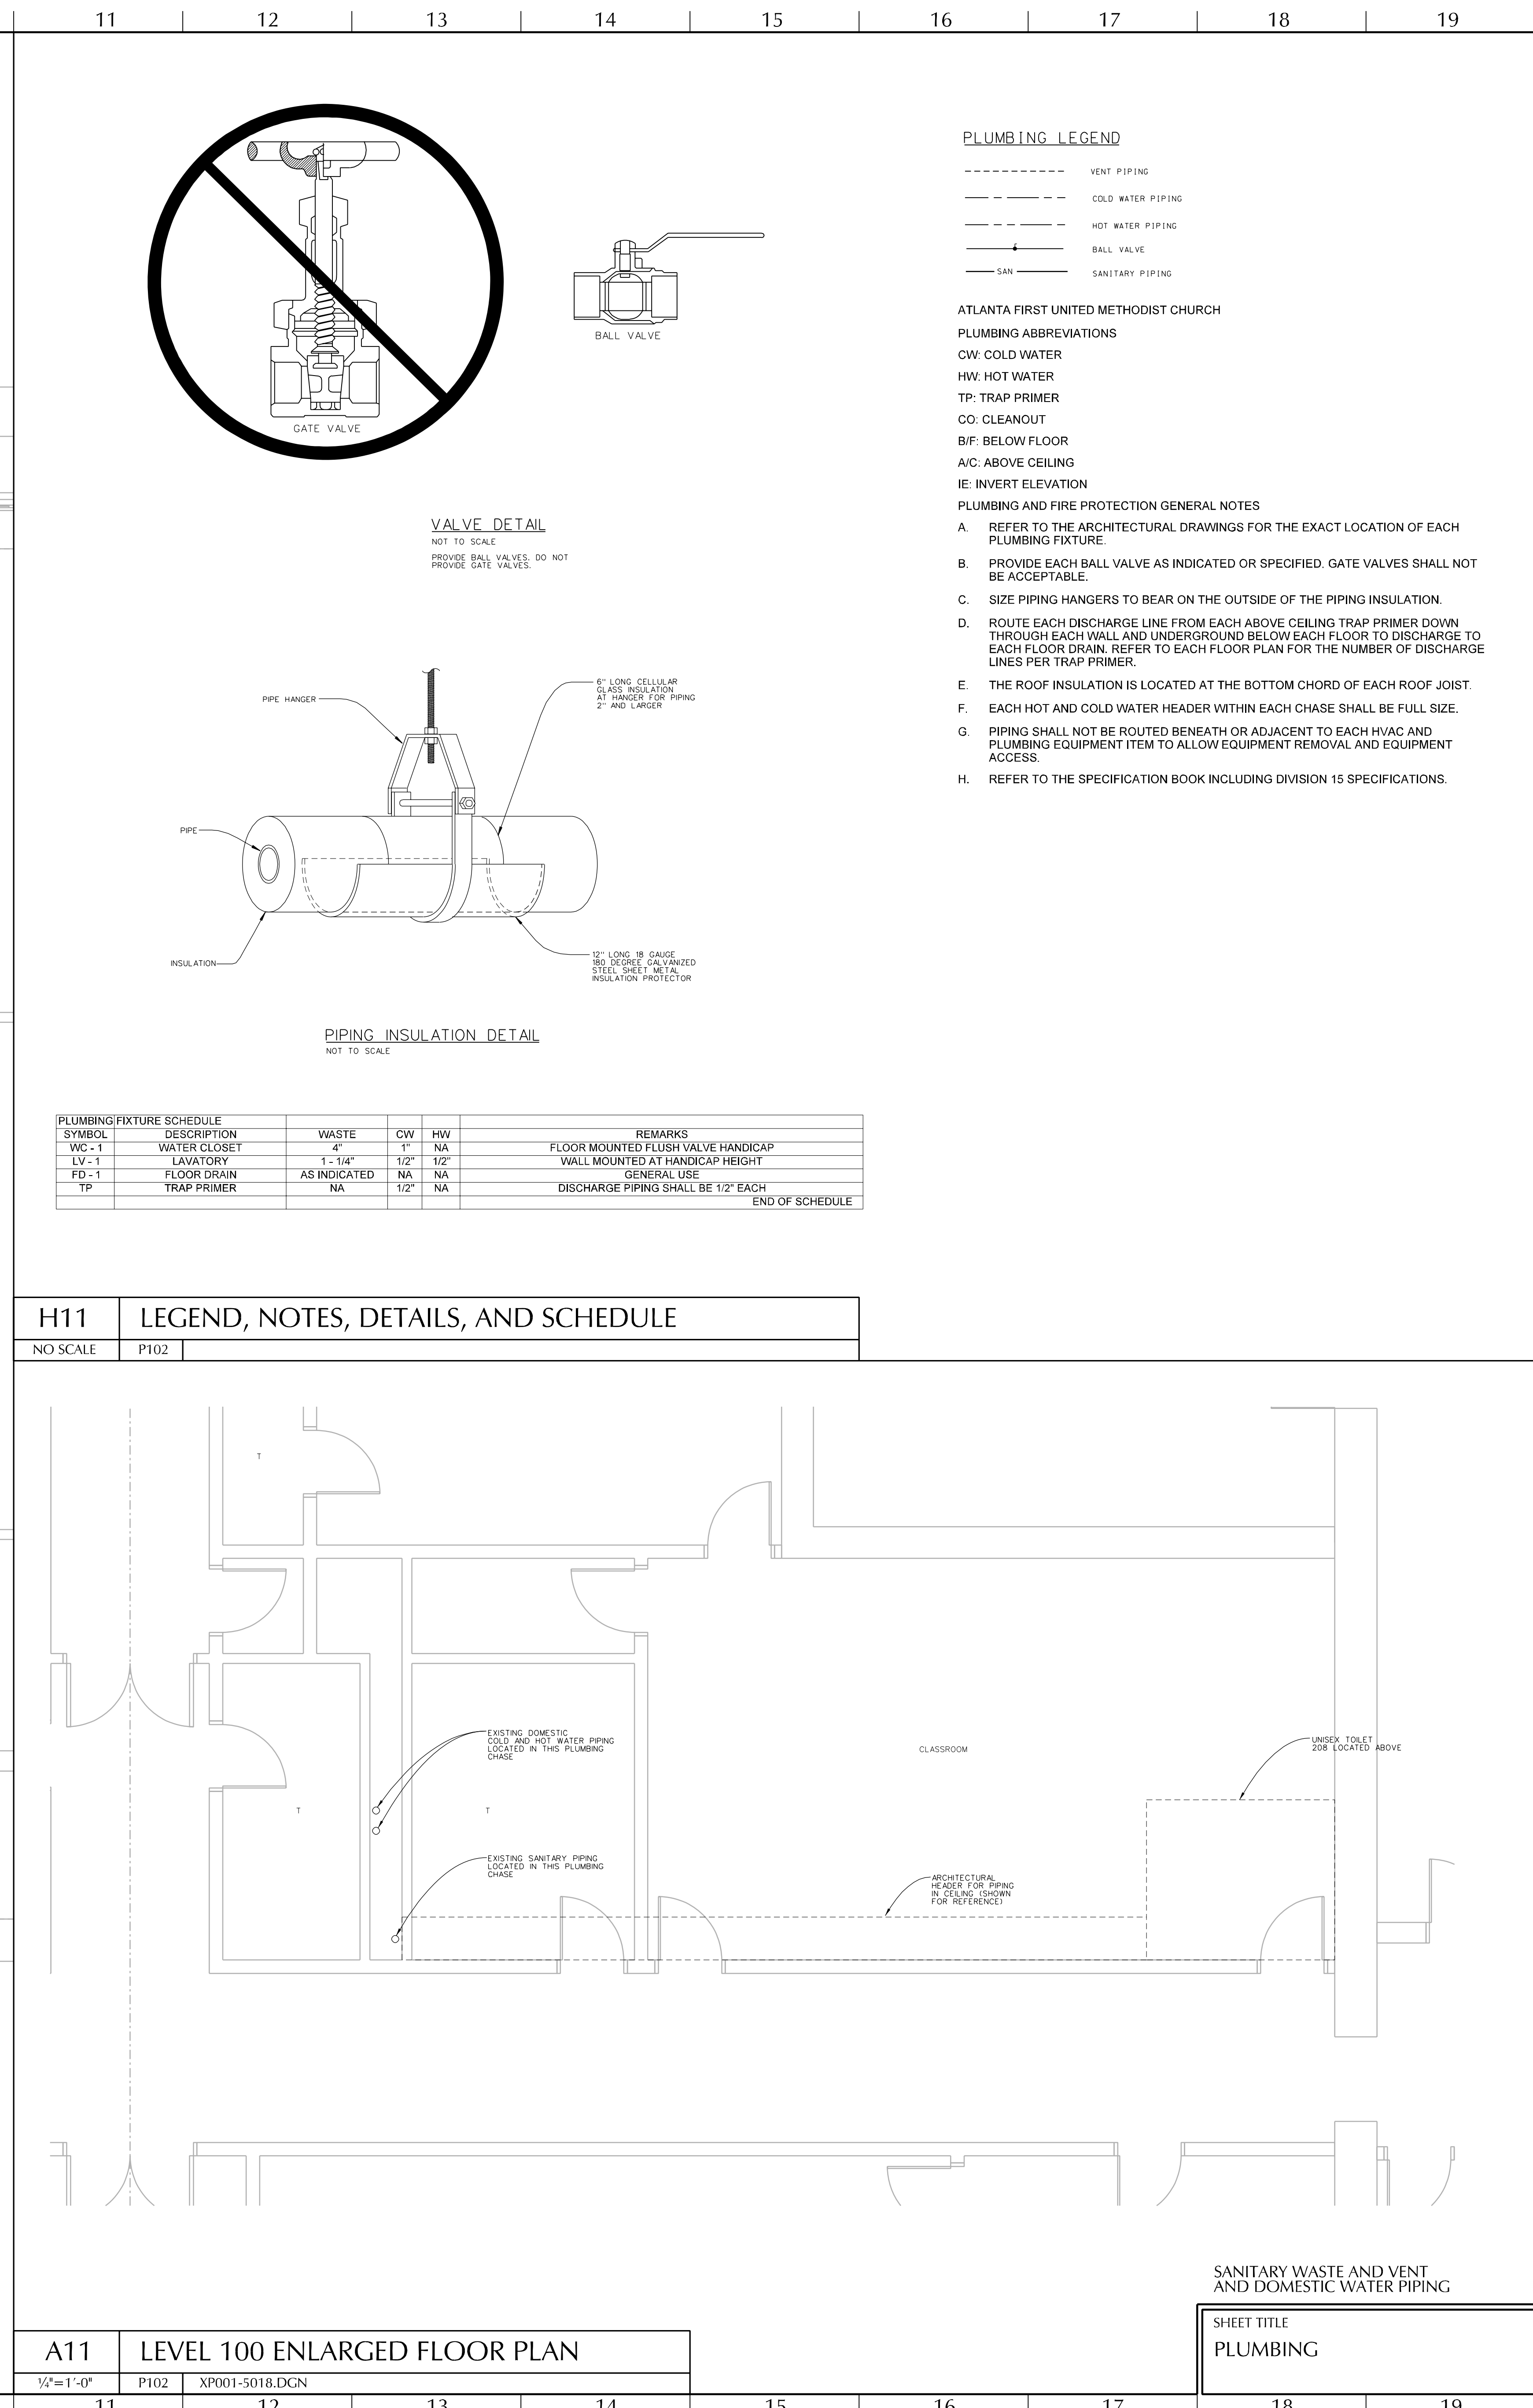

SHEET TITLE
HVAC



 <p>ARCHITECTURE ENGINEERING INTERIOR DESIGN CONSTRUCTION SERVICES</p> <p>675 Tower Road Marietta, Ga 30060-6958 Off: 770.423.0016 Fax: 770.424.0260 www.cdhipartners.com</p>	
	
<p>INTERIOR RENOVATION FOR</p> <p><b>ATLANTA FIRST UNITED METHODIST CHURCH</b></p> <p>360 PEACHTREE ST NE ATLANTA, GA 30308</p>	
<p>CS 11/04/2007</p> <p>AS BUILT DRAWINGS</p>	<p>PROJECT NO:</p> <ul style="list-style-type: none"> <li>2005-0018</li> </ul> <p>CAD FILE NAME:</p> <ul style="list-style-type: none"> <li>5018p102.dgn</li> </ul> <p><small>© COPYRIGHT © 2014 BY CDHI PARTNERS INC. All rights reserved. These documents, as instruments of service, remain the property of the architect and no part may be used or reproduced without prior written permission of the copyright owner.</small></p>
<p>DRAWING NUMBER</p> <p><b>P102</b></p> <p>2 OF 2</p>	



\*MOUNTING HEIGHTS ARE TO BOTTOM OF DEVICE.

LIGHTING FIXTURE SCHEDULE		
FIXTURE DESIGNATION	MANUFACTURER AND CATALOG NUMBER	LAMPS
B1	LITHONIA CAT#SB232MVOLTGE8101S	2-F032/735/ECO
E1	DAY-BRITE CAT#T232-UNV-1/2EB	2-F032/735/ECO
EM(G)	LITHONIA CAT#ELM2	INCL.
EMX	LITHONIA CAT#LHQMSW3R120/277H	INCL.
EMBP	BODINE CAT#B50 FLUOR EMERG BATTERY PACK	N/A
FL DL	JUNO CAT#PL642EU-232C-WH	1-CF42W/735

**GENERAL NOTES ON SPECIFICATIONS**  
(GENERAL NOTES APPLY TO ALL DRAWINGS AND SPECIFICATIONS)

1. IT SHALL BE THE RESPONSIBILITY OF THE ELECTRICAL CONTRACTOR BIDDING ON THIS WORK TO VISIT THE SITE OF THE PROJECT TO FAMILIARIZE HIMSELF WITH FIELD CONDITIONS WHICH MAY INHIBIT OR HINDER THE EXECUTION OF HIS WORK. HE SHALL FIELD VERIFY THE BRANCH CIRCUITS ASSOCIATED WITH THE DEMOLITION WORK. INVOLVED AND THE NEW WORK THAT SHALL BE INVOLVED WITH THE PORTION OF THE CIRCUITS TO BE DISCONNECTED WHILE MAINTAINING POWER TO OTHER PORTIONS OF THAT SAME EXISTING CIRCUIT. SUBMITTAL OF BID SHALL INDICATE THAT A THOROUGH SITE SURVEY HAS BEEN PERFORMED AND THAT THE WORK DESCRIBED CAN BE PERFORMED AS DESIGNED ON THIS DRAWING. IF A DISCREPANCY IS REALIZED AS A RESULT OF THIS E.C. SITE SURVEY, CONTACT THE PROJECT MANAGER FOR CLARIFICATION PRIOR TO SUBMITTING BID. SUBMITTAL OF BID SHALL INDICATE THAT A THOROUGH SITE SURVEY HAS BEEN PERFORMED. NO FUTURE CHANGE ORDERS RELATED TO UNKNOWN DIFFICULTIES OR UNANTICIPATED FIELD CONDITIONS WILL BE CONSIDERED.


2. THE DEMOLITION WORK SHALL FOLLOW THE FOLLOWING GUIDELINES AS WELL AS TO THOSE INDICATED IN THE SPECIFICATIONS:

- A. Make necessary modifications and adjustments to all electrical items and equipment, both new and existing as may be required by these alterations and additions.
- B. Disconnect at source and remove existing electrical materials and equipment, including but not limited to lighting fixtures, wiring devices, signal equipment, conduit and wires, and all other electrical items which are rendered obsolete by these alterations and additions. These are the property of the owner and shall either be removed from the site or returned to owner's stock at the discretion of the owner.
- C. Disconnect, remove, and relocate existing electrical materials and equipment, including but not limited to lighting fixtures, wiring devices, signal equipment, conduit and wires, and all other electrical items which interfere or are interfered with, obstruct or are obstructed by these alterations and additions. Permanently install such items in new locations as directed.
- D. Any equipment which is to be relocated and reconnected shall be carefully examined for any defects and tested for electrical continuity prior to relocation. Any defects or malfunctions detected shall be brought to the immediate attention of the Engineer. After the equipment has been certified to be in good electro-mechanical condition, the equipment may be relocated and thoroughly cleaned and retested for electrical continuity. The Electrical Subcontractor shall bear all expenses for any equipment damaged in the process of reinstatement and relocation and shall replace with new equipment or properly repair any damaged equipment to satisfaction of the Engineer.
- E. It shall be the Electrical Subcontractor's responsibility to maintain the existing building in electrical operation at all times during the entire construction period. If it is absolutely necessary to shut down, the Electrical Subcontractor shall consult with the Owner and the Engineer to make arrangements to do so on Saturdays or off hour periods at the Owner's convenience. Prior notice shall be given to the Owner and the Project Manager 48 hours in advance of the desired shut down time. Any premium or overtime costs necessary to accomplish the above shall be included in bid.
- F. Any electrical device not completely removed shall not be left without power. The contractor shall reconnect any device left without power due to the scope of work to the same size circuit(s) as previously served.

3. IT SHALL BE THE RESPONSIBILITY OF THE ELECTRICAL CONTRACTOR TO COORDINATE ELECTRICAL WORK WITH OTHER DIVISIONS. PARTICULAR ATTENTION SHOULD BE PAID TO DIVISION 15. WORK SHOULD ALSO BE COORDINATED AROUND PORTABLE AND MOBILE EQUIPMENT.

4. THE CONTRACTOR SHALL BE RESPONSIBLE FOR UPDATING THE EXISTING PANELBOARD SCHEDULES TO REFLECT CHANGES, DELETIONS, AND ADDITIONS BY THE SCOPE OF THIS WORK.

1. BUS TAP THE SECONDARY SIDE OF THE EXISTING 1200 AMP MAIN DISTRIBUTION PANEL FOR FEED TO FUSED DISCONNECT SWITCH.
2. NEW 200 AMP FUSED DISCONNECT SWITCH, 3 POLES NEMA 1, FUSED AT 200 AMPS. MOUNT SWITCH NEAR EXISTING MAIN PANEL (FIELD COORDINATE). CONDUCTOR LENGTH SHALL NOT EXCEED 10 FEET IN LENGTH.
3. PROVIDE INTEGRAL SURGE SUPPRESSION DEVICE IN PANEL INDICATED.
4. INSTALL PANEL IN BELL TOWER ON WALL ADJACENT TO ABANDONED MECHANICAL PUMPS. COORDINATE EXACT LOCATION WITH ENGINEER PRIOR TO INSTALLATION.
5. NEW ITEMS SHOWN IN BOLD. ITEMS TO REMAIN IN PLACE SHOWN AS SHADED FOR INFORMATION ONLY.
6. FAULT CURRENT AS CALCULATED BY ENGINEER.

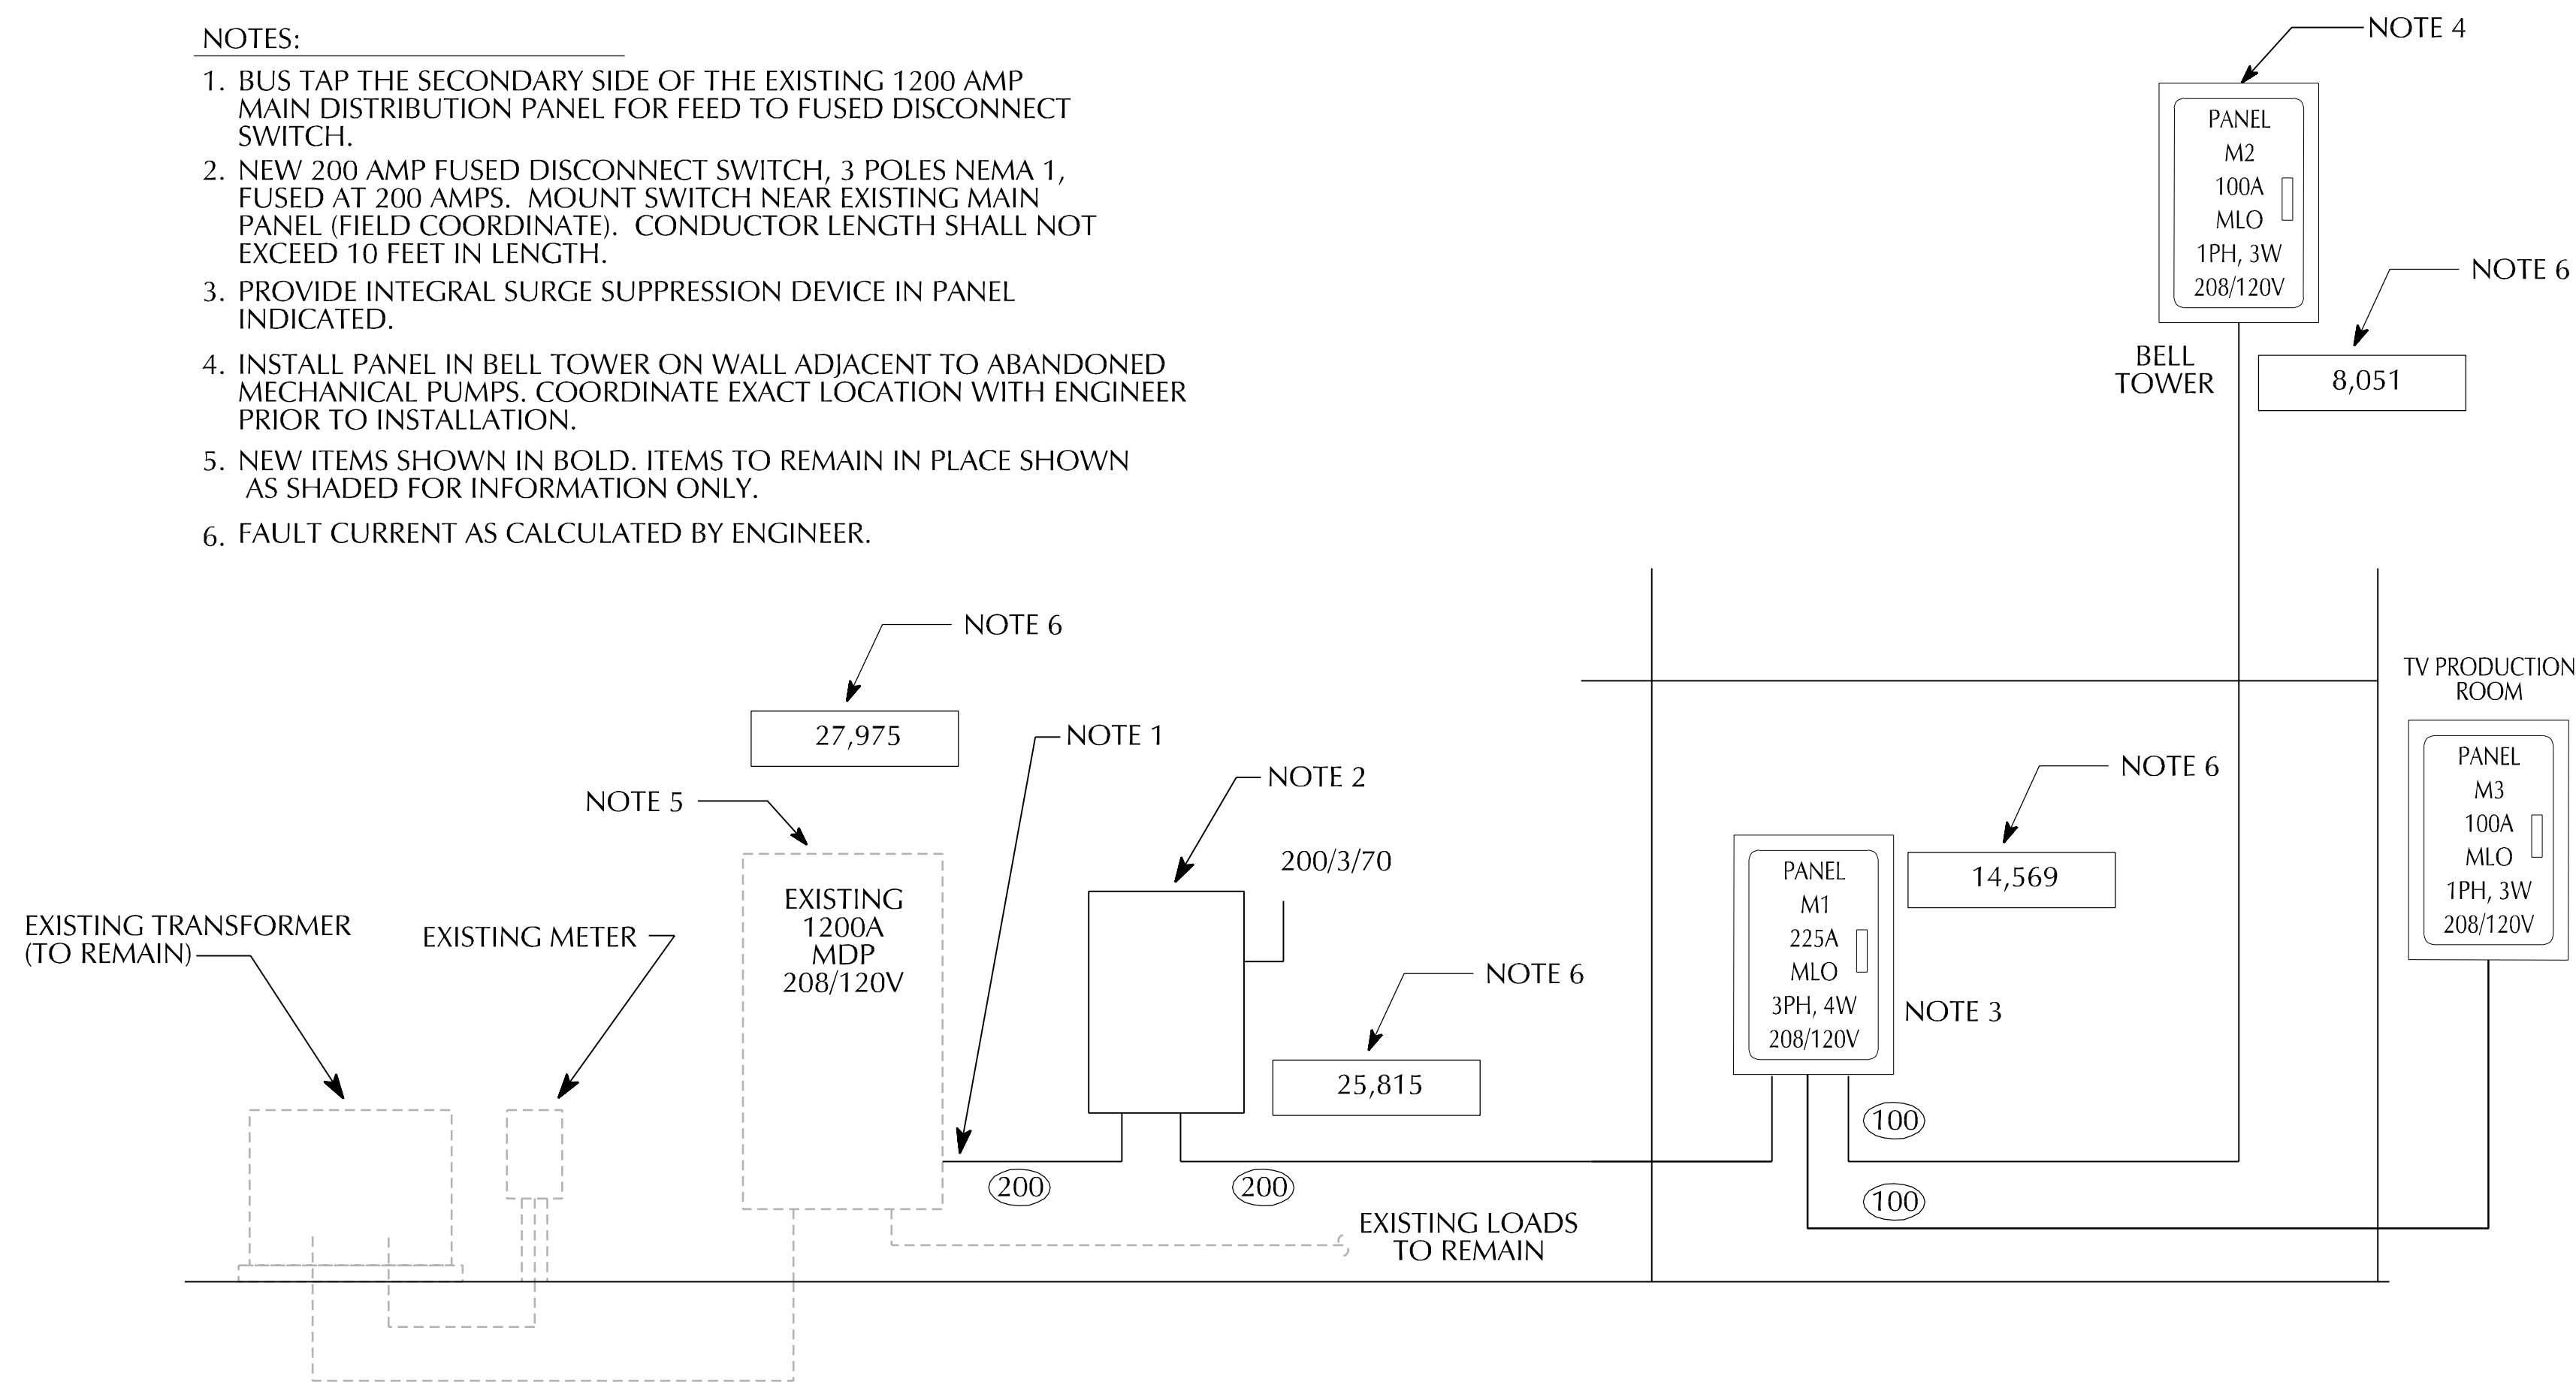

A1	ELECTRICAL SYSTEM RISER DIAGRAM
NTS	E002

KEY PLAN

SHEET TITLE  
LEGEND, ONE-LINE,  
SCHEDULES AND NOTES

g:\D\2005-0018\Design\5018e002.dgn  
lundy  
9:05:00 AM  
10/19/2007

12345678910111213141516171819

PANEL NAME			LOCATION:	VOLTAGE: 208 Y/ 120V 3 PHASE							MOUNTING / ENCLOSURE:		SURFACE / NEMA 1		
M1			BLOWER ROOM	225A MLO											
AMPS	POLES	TYPE	CIRCUIT DESCRIPTION	KVA	CKT	A	B	C	CKT	KVA	CIRCUIT DESCRIPTION	TYPE	POLES	AMPS	
100	2		100-AMP SUB-PANEL M2	2.00	1	4.90			2	2.90	LARGE BLOWER 7.5 HP	M	3	50	
				2.00	3		4.90		4	2.90					
20	1	R	SPARE		5			2.90	6	2.90					
20	1	R	RECEPT AV	0.18	7	0.74			8	0.56	CONSOLE CIRCUIT NO.1	R	1	20	
20	1	R	RECEPT FRONT ORGAN	0.18	9		1.68		10	1.50	BALCONY BLOWER NO.2	M	2	30	
20	1	R	RECEPT FRONT ORGAN	0.18	11			1.68	12	1.50					
20	1	R	RECEPT FRONT ORGAN	0.18	13	0.36			14	0.18	RECEPT AV	R	1	20	
20	1	R	RECEPT FRONT ORGAN	0.18	15		0.36		16	0.18	RECEPT REAR ORGAN	R	1	20	
20	1	R	RECEPT FRONT ORGAN	0.18	17			0.36	18	0.18	RECEPT REAR ORGAN	R	1	20	
20	1	R	RECEPT FRONT ORGAN	0.18	19	0.36			20	0.18	RECEPT AV	R	1	20	
20	1	R	RECEPT FRONT ORGAN	0.18	21		0.36		22	0.18	RECEPT REAR ORGAN		1	20	
20	1	R	LIGHTING ORGAN	0.18	23			0.36	24	0.18	RECEPT REAR ORGAN	L	1	20	
20	1	R	LIGHTING BALCONY ORG.	1.54	25	1.72			26	0.18	RECEPT AV	R	1	20	
20	1	R	WHEEL CHAIR LIFT	0.18	27		0.36		28	0.18	CONSOLE CIRCUIT NO.2	R	1	20	
20	1	R	CHANCEL FLR BOX SPLIT	0.72	29			0.82	30	0.10	CONSOLE STORAGE LIGHT	L	1	20	
20	1	R	RECEPT DBL QUAD	0.72	31	1.08			32	0.36	RECEPT AV	R	1	20	
100	2	R	100-AMP SUB-PANEL M3	9.50	33		10.22		34	0.72	CHANCEL FLR BOX	R	1	20	
		R		7.60	35			8.32	36	0.72	RECEPTS-PASSAGE ROOM	R	1	20	
20	3	M	ORGAN LIFT	1.50	37	1.60			38	0.10	SURGE SUPPRESSOR		3	30	
		M		1.50	39		1.60		40	0.10					
		M		1.50	41			1.60	42	0.10					
* HACR TYPE BREAKER				PHAS		10.8	19.5	16.0	KVA						
** GROUND FAULT CIRCUIT INTERRUPTER BREAKER											TOTAL CONNECTED LOAD		46 KVA		128 A
*** ARC FAULT CIRCUIT INTERRUPTER BREAKER											TOTAL DEMAND LOAD		42 KVA		116 A

- NOTES:
- CONNECT TO EXISTING LIGHTING CIRCUIT LEFT OVER FROM DEMOLITION OF STORAGE SPACE. EXHAUST FAN TO BE CONTROLLED BY LIGHT SWITCH.
  - ALL AUDIO / VISUAL CIRCUITS NEED TO HAVE A DEDICATED NEUTRAL AND HAVE THE SAME PHASE. COORDINATE WITH AUDIO / VISUAL CONTRACTOR BEFORE LANDING HOMERUN CONDUCTORS TO INSURE EACH CIRCUIT IS ON THE SAME PHASE IN PANEL M1.


PANEL NAME			LOCATION:	VOLTAGE: 120 / 208 V SINGLE PHASE							MOUNTING / ENCLOSURE: SURFACE / NEMA 1				
M2			BELL TOWER	100 MLO							AVAIL. FAULT CURRENT:				
											SHORT CIRCUIT RATINGEXISTING				
AMPS	POLES	TYPE	CIRCUIT DESCRIPTION	KVA	CKT	A		B	CKT	KVA	CIRCUIT DESCRIPTION	TYPE	POLES	AMPS	
20	1	M	CHANDELIER WINCH	1.00	1	2.00			2	1.00	CHANDELIER WINCH	M	1	20	
20	1	M	CHANDELIER WINCH	1.00	3			2.00	4	1.00	CHANDELIER WINCH	M	1	20	
20	1		SPARE	0.00	5				6	0.00	SPARE	R	1	20	
20	1		SPARE	0.00	7				8	0.00	SPARE	R	1	20	
* HACR TYPE BREAKER					PHAS		2.0		2.0	KVA					
** GROUND FAULT CIRCUIT INTERRUPTER BREAKER											TOTAL CONNECTED LOAD		4 KVA		17 A
*** ARC FAULT CIRCUIT INTERRUPTER BREAKER											TOTAL DEMAND LOAD		7 KVA		27 A

MECHANICAL EQUIPMENT SCHEDULE

EQUIPMENT NAME	LOCATION / SERVES	VOLTAGE	PHASE	HP	KW	KW / POLE	FLA	MCA	MOCP	BREAKER AMPACITY	PANEL	FEEDER	DISCONNECT (NOTE 1)				CONTROL
													SIZE	POLES	FUSE SIZE	ENCLOSURE	
F-1	NEW UNI-SEX BATHROOM	120	1	0.07		0.36	0.0			20	EXISTING	2 # 12 ,1# 12 G 1/2 "C.	30	1	NF	NEMA 1	INTERLOCK WITH LIGHTS (NOTE 1)

- NOTES:
- REFER TO DETAIL F6 ON DRAWING E001 FOR FAN CONNECTION DETAIL.

PANEL NAME			LOCATION:	VOLTAGE: 120 / 208 V							SINGLE PHASE		MOUNTING / ENCLOSURE: SURFACE / NEMA 1			
M3			TV PRODUCTION	100 MLO							AVAIL. FAULT CURRENT:					
											SHORT CIRCUIT RATINGEXISTING					
AMPS	POLES	TYPE	CIRCUIT DESCRIPTION	KVA	CKT	A		B	CKT	KVA	CIRCUIT DESCRIPTION	TYPE	POLES	AMPS		
20	2	R	RECEPTS HVAC	1.90	1	1.90			2		SPACE					
		R		1.90	3			3.80	4	1.90	RECEPTS	R	1	20		
20	1	R	RECEPTS	1.90	5	1.90			6		SPACE					
20	1		SPARE		7			1.90	8	1.90	RECEPTS	R	1	20		
20	1	R	RECEPTS	1.90	9	1.90			10		SPACE					
			SPACE		11			1.90	12	1.90	RECEPTS	R	1	20		
20	1	R	RECEPTS	1.90	13	1.90			14		SPACE					
			SPACE		15				16		SPACE					
20	1	R	RECEPTS	1.90	17	1.90			18		SPACE					
				19				20		SPACE						
				PHAS		9.5		7.6	KVA							
												TOTAL CONNECTED LOAD		17 KVA	71 A	
												TOTAL DEMAND LOAD		14 KVA	56 A	

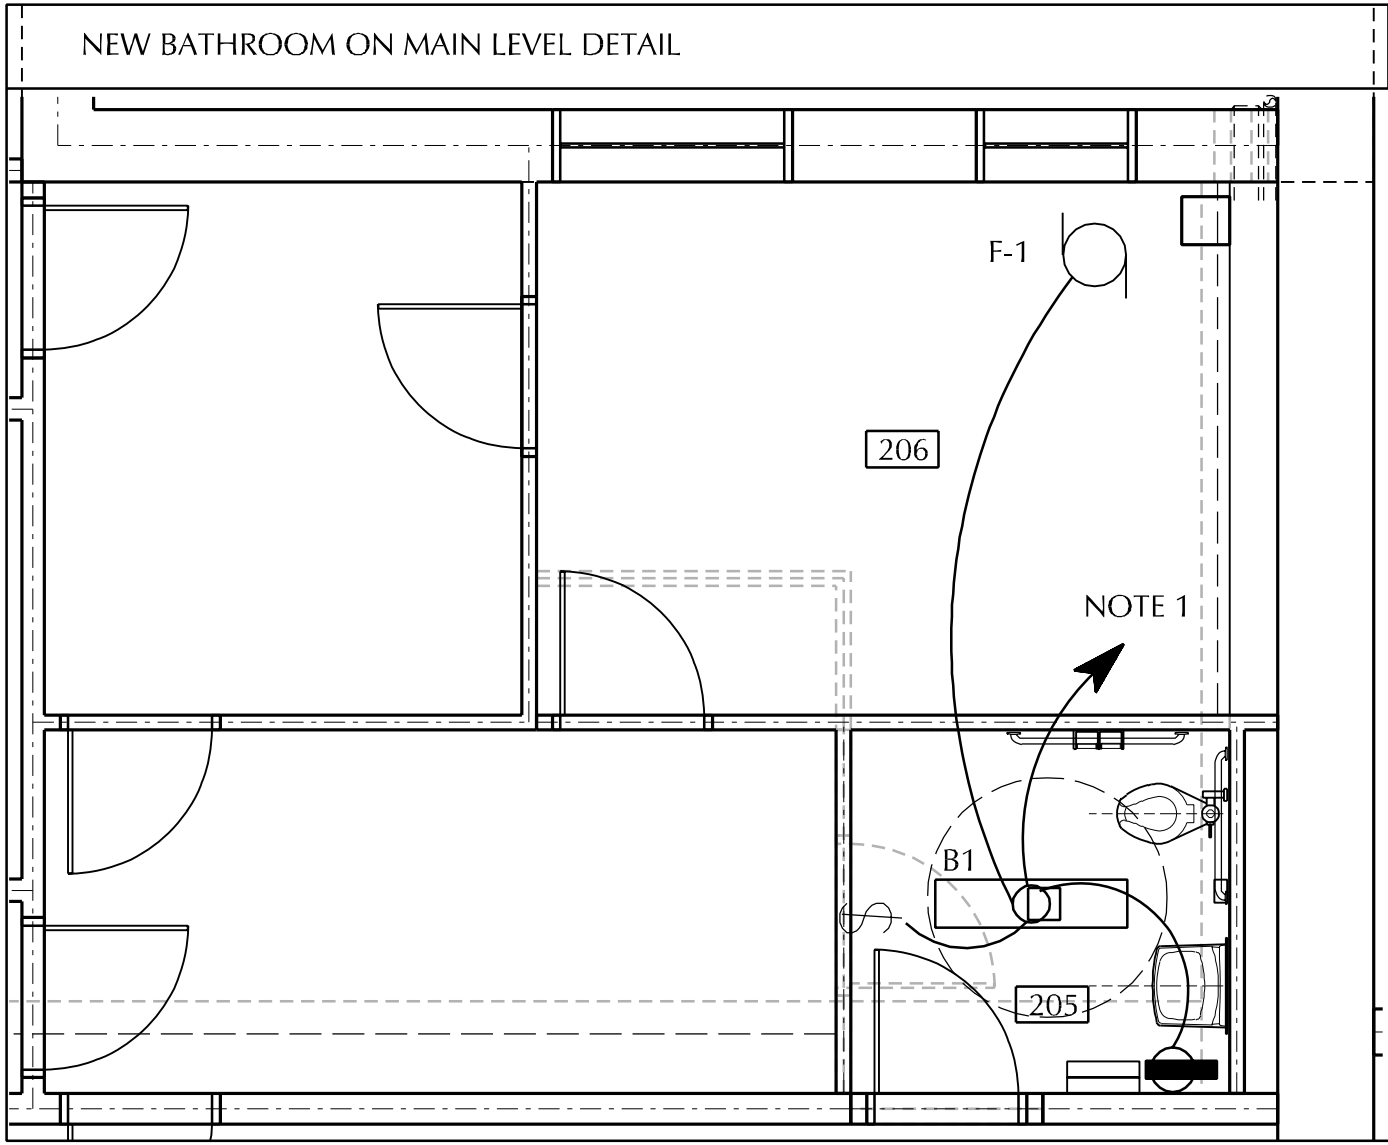

KEY PLAN

SHEET TITLE  
PANEL SCHEDULE  
BATHROOM DETAIL

CDH  
PARTNERS

ARCHITECTURE  
ENGINEERING  
INTERIOR DESIGN  
CONSTRUCTION SERVICES

675 Tower Road  
Marietta, Ga 30060-6958  
Off: 770.423.0016  
Fax: 770.424.0260  
www.cdhparkers.com

INTERIOR RENOVATION FOR  
ATLANTA FIRST  
UNITED METHODIST CHURCH  
360 PEACHTREE ST NE ATLANTA, GA 30308


11/04/2007  
765 BUILT DRAWINGS

PROJECT NO:  
• 2005-0018  
CAD FILE NAME:  
• ...5018e002.dgn

COPYRIGHT © 2004 by CDH PARTNERS INC.  
All rights reserved. These documents,  
as instruments of service, remain the  
property of the architect and no part  
may be used or reproduced without  
prior written permission of the  
copyright owner.

DRAWING NUMBER  
E002  
OF



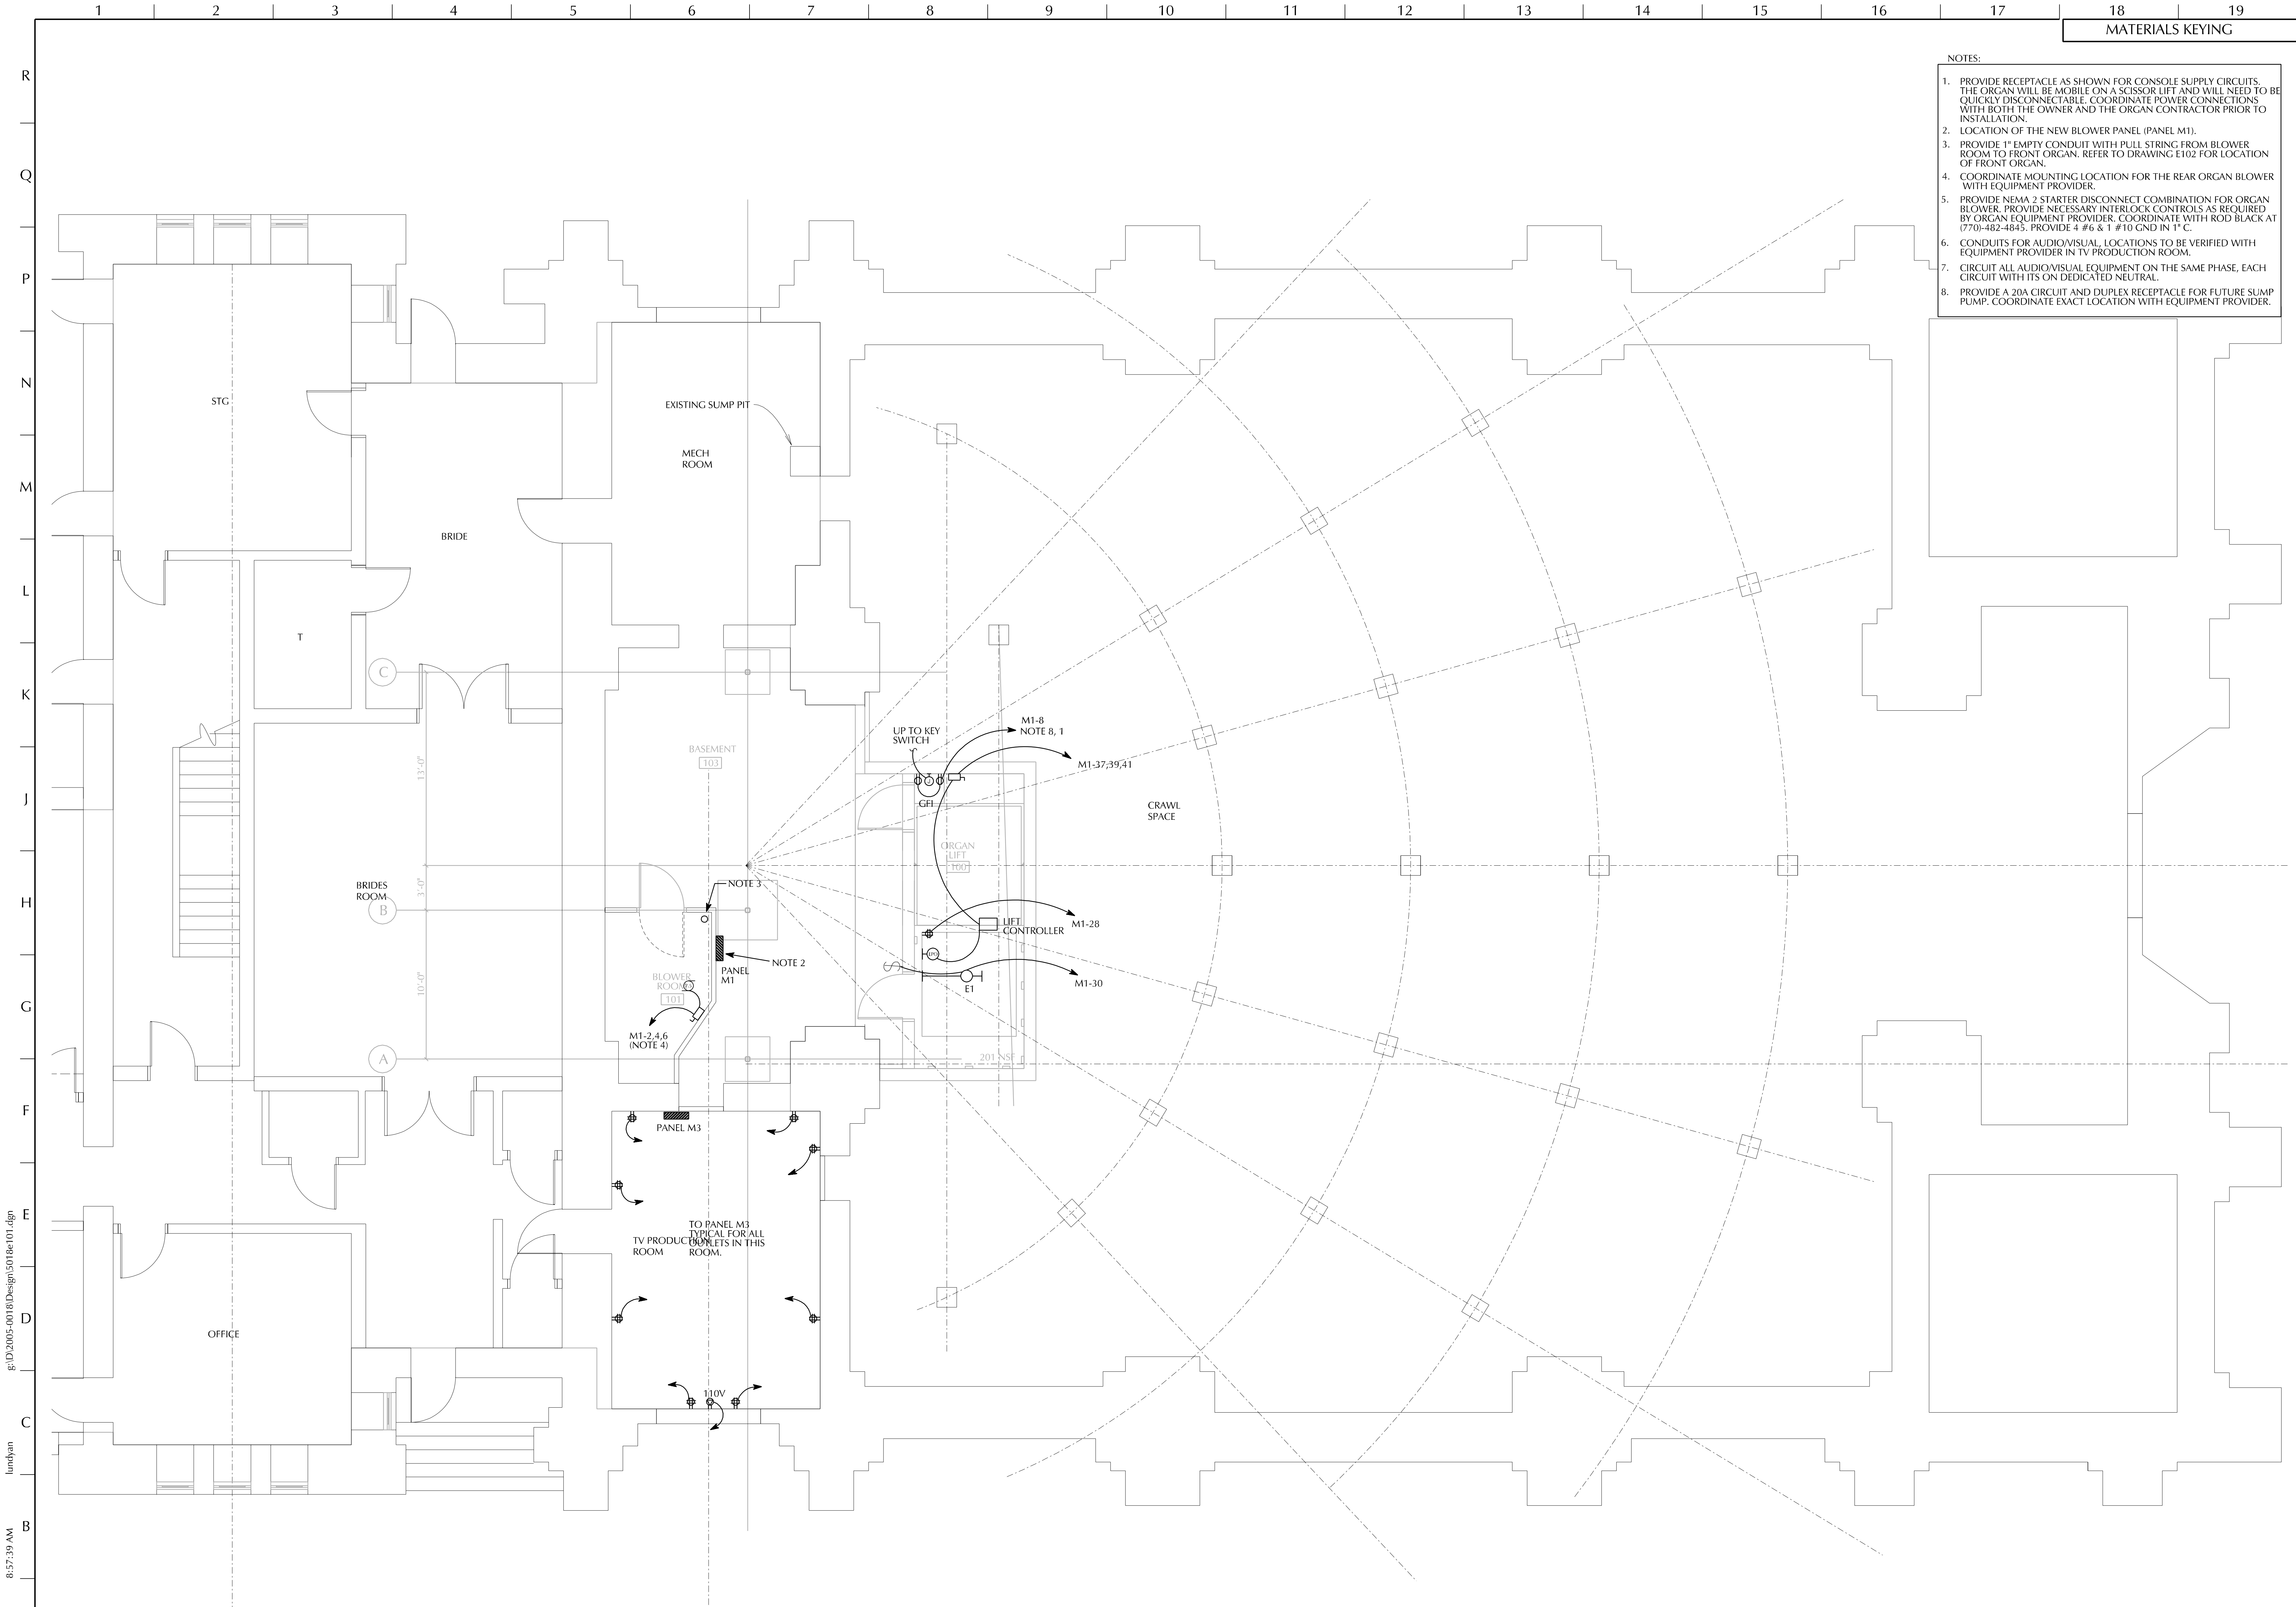

- NOTES:
1. PROVIDE RECEPTACLE AS SHOWN FOR CONSOLE SUPPLY CIRCUITS. THE ORGAN WILL BE MOBILE ON A SCISSOR LIFT AND WILL NEED TO BE QUICKLY DISCONNECTABLE. COORDINATE POWER CONNECTIONS WITH BOTH THE OWNER AND THE ORGAN CONTRACTOR PRIOR TO INSTALLATION.
  2. LOCATION OF THE NEW BLOWER PANEL (PANEL M1).
  3. PROVIDE 1" EMPTY CONDUIT WITH PULL STRING FROM BLOWER ROOM TO FRONT ORGAN. REFER TO DRAWING E102 FOR LOCATION OF FRONT ORGAN.
  4. COORDINATE MOUNTING LOCATION FOR THE REAR ORGAN BLOWER WITH EQUIPMENT PROVIDER.
  5. PROVIDE NEMA 2 STARTER DISCONNECT COMBINATION FOR ORGAN BLOWER. PROVIDE NECESSARY INTERLOCK CONTROLS AS REQUIRED BY ORGAN EQUIPMENT PROVIDER. COORDINATE WITH ROD BLACK AT (770)-482-4845. PROVIDE 4 #6 & 1 #10 GND IN 1" C.
  6. CONDUITS FOR AUDIO/VISUAL, LOCATIONS TO BE VERIFIED WITH EQUIPMENT PROVIDER IN TV PRODUCTION ROOM.
  7. CIRCUIT ALL AUDIO/VISUAL EQUIPMENT ON THE SAME PHASE, EACH CIRCUIT WITH ITS ON DEDICATED NEUTRAL.
  8. PROVIDE A 20A CIRCUIT AND DUPLEX RECEPTACLE FOR FUTURE SUMP PUMP. COORDINATE EXACT LOCATION WITH EQUIPMENT PROVIDER.

CDHPARTNERS

ARCHITECTURE  
ENGINEERING  
INTERIOR DESIGN  
CONSTRUCTION SERVICES

675 Tower Road  
Marietta, Ga 30060-6958  
Off: 770.423.0016  
Fax: 770.424.0260  
www.cdhparkers.com

INTERIOR RENOVATION FOR  
ATLANTA FIRST  
UNITED METHODIST CHURCH  
360 PEACHTREE ST NE ATLANTA, GA 30308

11/04/2007  
76 BUILT DRAWINGS

PROJECT NO:  
• 2005-0018  
CAD FILE NAME:  
• ...5018e101.dgn


COPYRIGHT © 2004 by CDH PARTNERS INC.  
All rights reserved. These documents,  
as instruments of service, remain the  
property of the architect and no part  
may be used or reproduced without  
prior written permission of the  
copyright owner.

DRAWING NUMBER  
**E101**  
OF

10/19/2007 8:57:39 AM lundyan g:\D\2005-0018\Design\5018e101.dgn

A1	LEVEL 100 FLOOR PLAN		SHEET TITLE LEVEL 100 FLOOR PLAN	
1/4"=1'-0"	A101	AP001-5018.DGN		



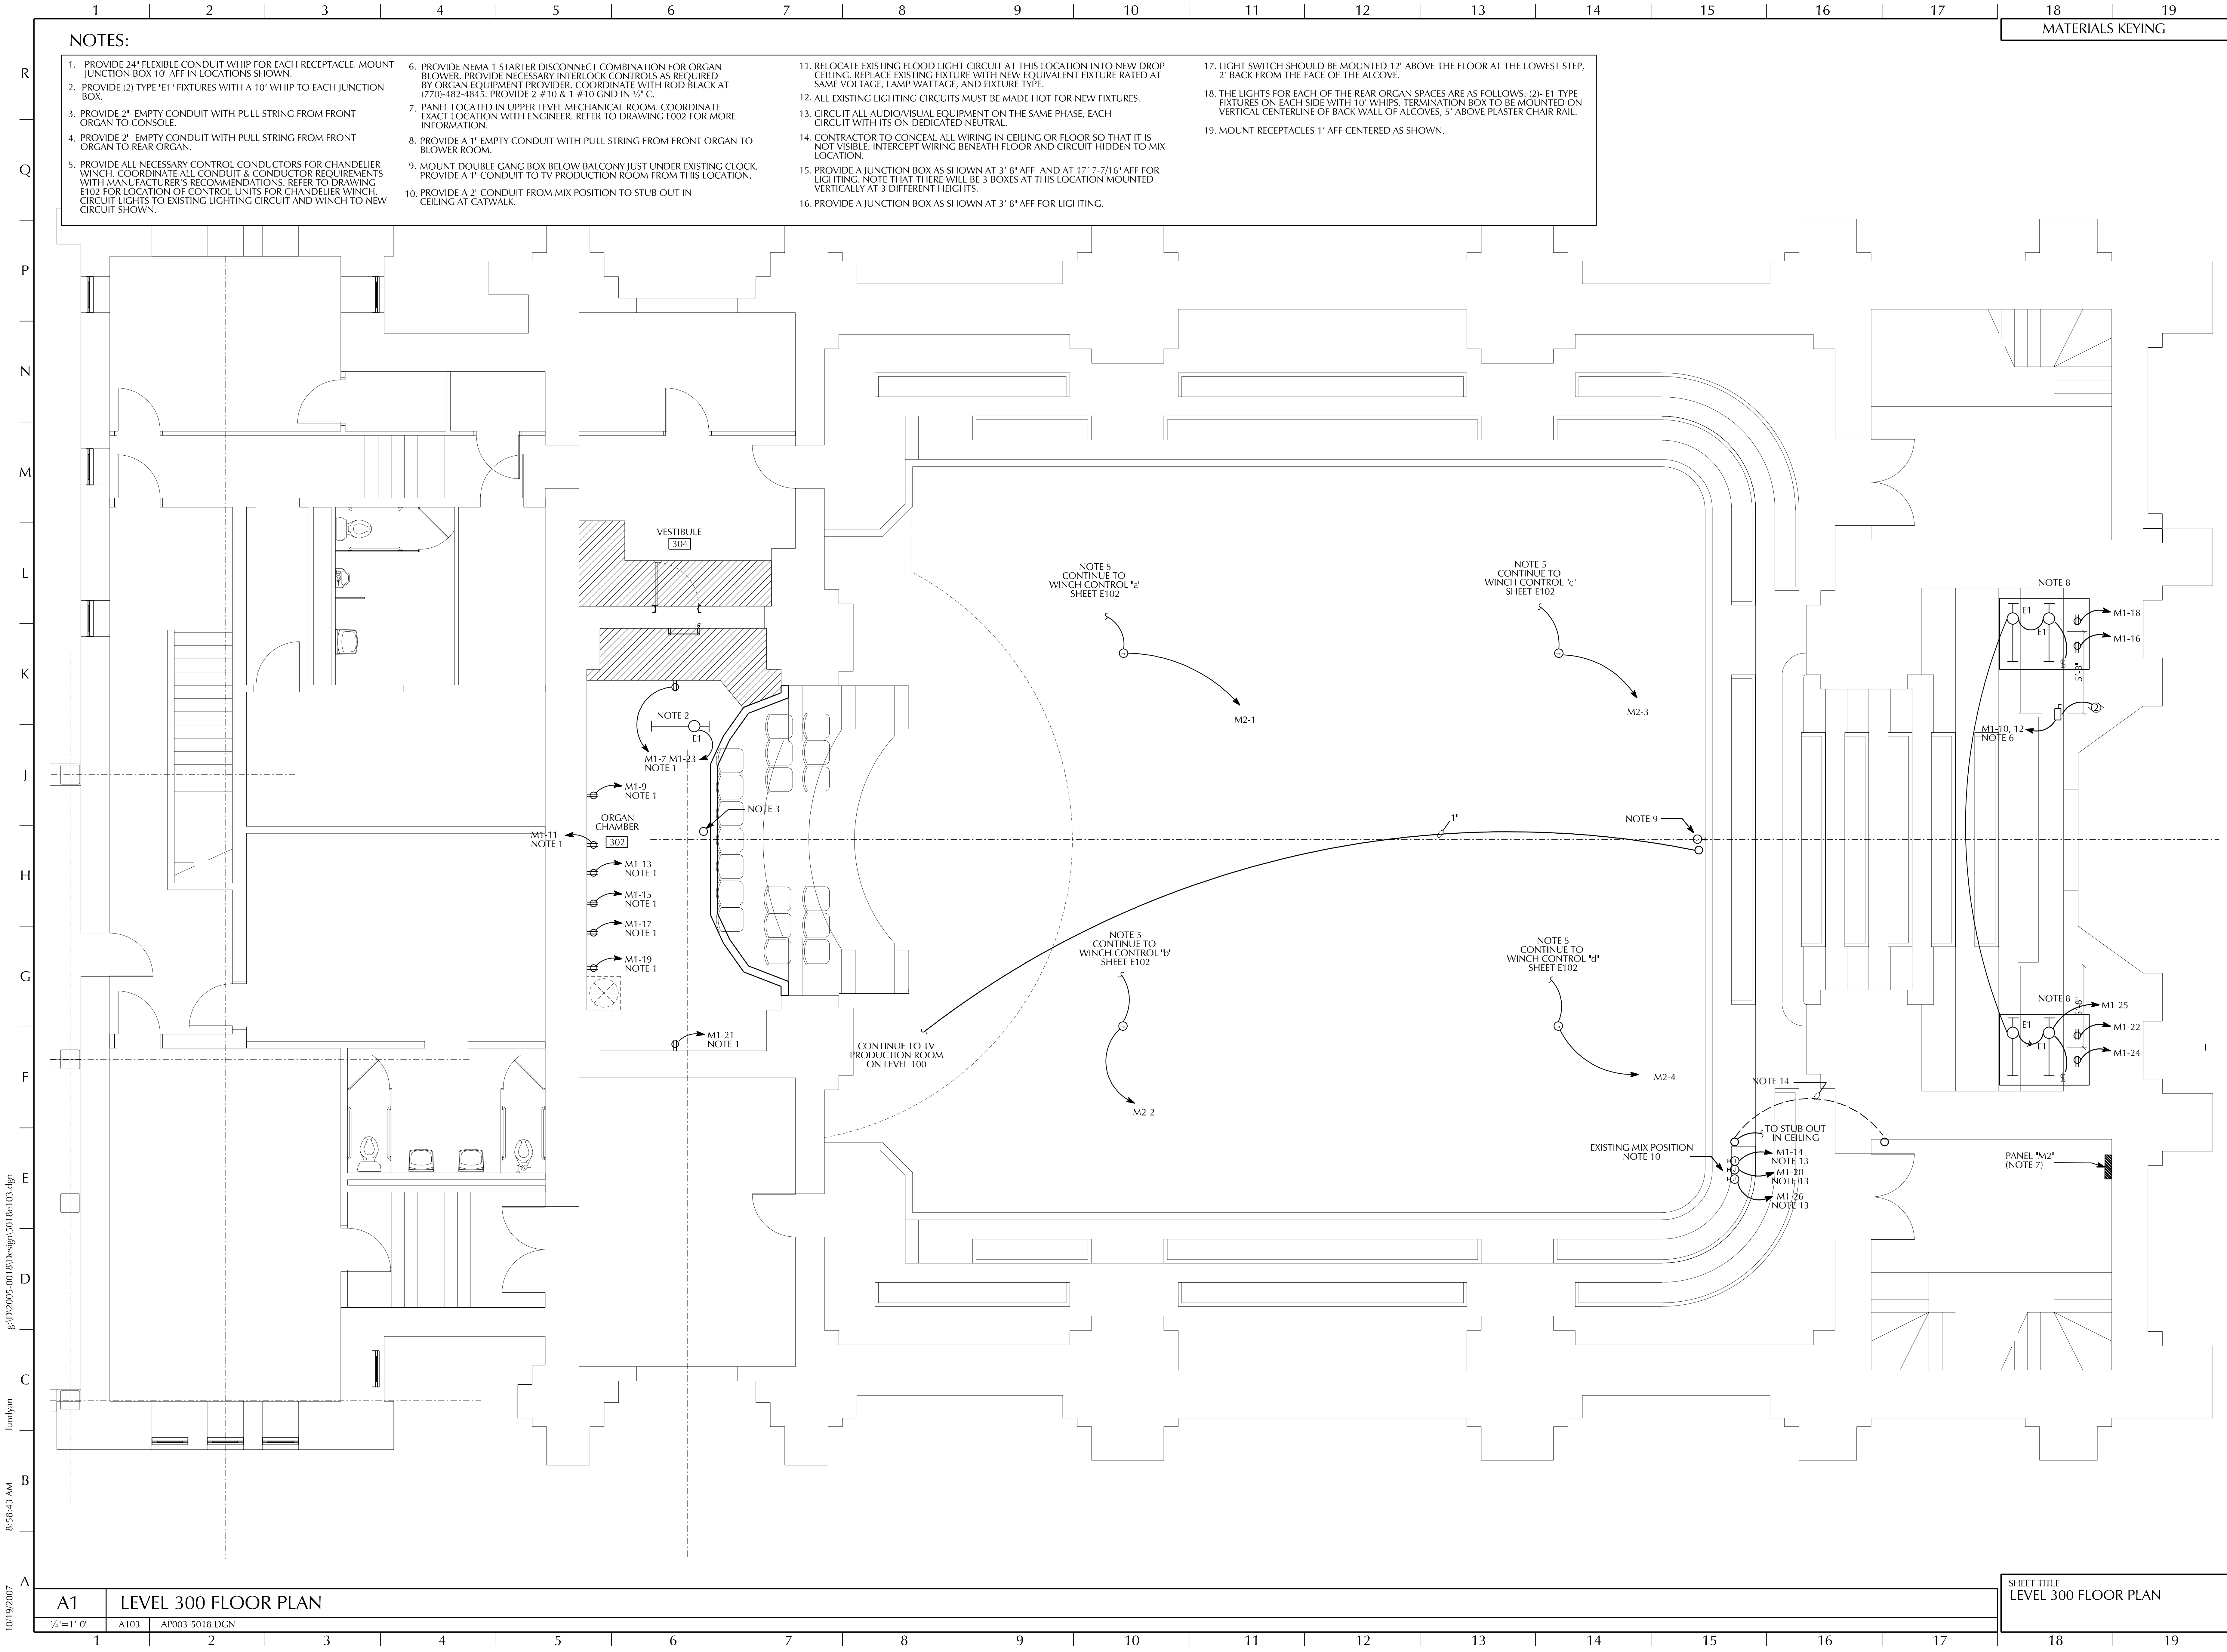

- NOTES:
1. PROVIDE 24" FLEXIBLE CONDUIT WHIP FOR EACH RECEPTACLE. MOUNT JUNCTION BOX 10" AFF IN LOCATIONS SHOWN.

2. PROVIDE (2) TYPE "E1" FIXTURES WITH A 10' WHIP TO EACH JUNCTION BOX.

3. PROVIDE 2" EMPTY CONDUIT WITH PULL STRING FROM FRONT ORGAN TO CONSOLE.

4. PROVIDE 2" EMPTY CONDUIT WITH PULL STRING FROM FRONT ORGAN TO REAR ORGAN.

5. PROVIDE ALL NECESSARY CONTROL CONDUCTORS FOR CHANDELIER WINCH. COORDINATE ALL CONDUIT & CONDUCTOR REQUIREMENTS WITH MANUFACTURER'S RECOMMENDATIONS. REFER TO DRAWING E102 FOR LOCATION OF CONTROL UNITS FOR CHANDELIER WINCH. CIRCUIT LIGHTS TO EXISTING LIGHTING CIRCUIT AND WINCH TO NEW CIRCUIT SHOWN.

6. PROVIDE NEMA 1 STARTER DISCONNECT COMBINATION FOR ORGAN BLOWER. PROVIDE NECESSARY INTERLOCK CONTROLS AS REQUIRED BY ORGAN EQUIPMENT PROVIDER. COORDINATE WITH ROD BLACK AT (770)-482-4845. PROVIDE 2 #10 & 1 #10 GND IN 1/2" C.

7. PANEL LOCATED IN UPPER LEVEL MECHANICAL ROOM. COORDINATE EXACT LOCATION WITH ENGINEER. REFER TO DRAWING E002 FOR MORE INFORMATION.

8. PROVIDE A 1" EMPTY CONDUIT WITH PULL STRING FROM FRONT ORGAN TO BLOWER ROOM.

9. MOUNT DOUBLE GANG BOX BELOW BALCONY JUST UNDER EXISTING CLOCK. PROVIDE A 1" CONDUIT TO TV PRODUCTION ROOM FROM THIS LOCATION.

10. PROVIDE A 2" CONDUIT FROM MIX POSITION TO STUB OUT IN CEILING AT CATWALK.

11. RELOCATE EXISTING FLOOD LIGHT CIRCUIT AT THIS LOCATION INTO NEW DROP CEILING. REPLACE EXISTING FIXTURE WITH NEW EQUIVALENT FIXTURE RATED AT SAME VOLTAGE, LAMP WATTAGE, AND FIXTURE TYPE.

12. ALL EXISTING LIGHTING CIRCUITS MUST BE MADE HOT FOR NEW FIXTURES.

13. CIRCUIT ALL AUDIO/VISUAL EQUIPMENT ON THE SAME PHASE, EACH CIRCUIT WITH ITS ON DEDICATED NEUTRAL.

14. CONTRACTOR TO CONCEAL ALL WIRING IN CEILING OR FLOOR SO THAT IT IS NOT VISIBLE. INTERCEPT WIRING BENEATH FLOOR AND CIRCUIT HIDDEN TO MIX LOCATION.

15. PROVIDE A JUNCTION BOX AS SHOWN AT 3' 8" AFF AND AT 17' 7-7/16" AFF FOR LIGHTING. NOTE THAT THERE WILL BE 3 BOXES AT THIS LOCATION MOUNTED VERTICALLY AT 3 DIFFERENT HEIGHTS.

16. PROVIDE A JUNCTION BOX AS SHOWN AT 3' 8" AFF FOR LIGHTING.

17. LIGHT SWITCH SHOULD BE MOUNTED 12" ABOVE THE FLOOR AT THE LOWEST STEP, 2" BACK FROM THE FACE OF THE ALCOVE.

18. THE LIGHTS FOR EACH OF THE REAR ORGAN SPACES ARE AS FOLLOWS: (2)- E1 TYPE FIXTURES ON EACH SIDE WITH 10' WHIPS. TERMINATION BOX TO BE MOUNTED ON VERTICAL CENTERLINE OF BACK WALL OF ALCOVES, 5' ABOVE PLASTER CHAIR RAIL.

19. MOUNT RECEPTACLES 1' AFF CENTERED AS SHOWN.

CDH PARTNERS

ARCHITECTURE  
ENGINEERING  
INTERIOR DESIGN  
CONSTRUCTION SERVICES

675 Tower Road  
Marietta, Ga 30060-6958  
Off: 770.423.0016  
Fax: 770.424.0260  
www.cdhpartners.com

INTERIOR RENOVATION FOR  
ATLANTA FIRST  
UNITED METHODIST CHURCH  
360 PEACHTREE ST NE ATLANTA, GA 30308

10/04/2007  
AS BUILT DRAWINGS

PROJECT NO:  
• 2005-0018

CAD FILE NAME:  
• ...5018e103.dgn

COPYRIGHT © 2004 by CDH PARTNERS INC.  
All rights reserved. These documents,  
as instruments of service, remain the  
property of the architect and no part  
may be used or reproduced without  
prior written permission of the  
copyright owner.

DRAWING NUMBER  
E103  
OF

A1	LEVEL 300 FLOOR PLAN
1/8"=1'-0"	A103 AP003-5018.DGN

SHEET TITLE LEVEL 300 FLOOR PLAN
-------------------------------------



INTERIOR RENOVATION FOR  
**ATLANTA FIRST  
UNITED METHODIST CHURCH**  
360 PEACHTREE ST NE ATLANTA, GA 30308

10/04/2007
'AS BUILT' DRAWINGS


PROJECT NO:  
● 2005-0018

CAD FILE NAME:  
● ...\\5018e111.dgn

COPYRIGHT © 2004 by CDH PARTNERS INC.  
All rights reserved. These documents,  
as instruments of service, remain the  
property of the architect and no part  
may be used or reproduced without  
prior written permission of the  
copyright owner.

DRAWING NUMBER

E111

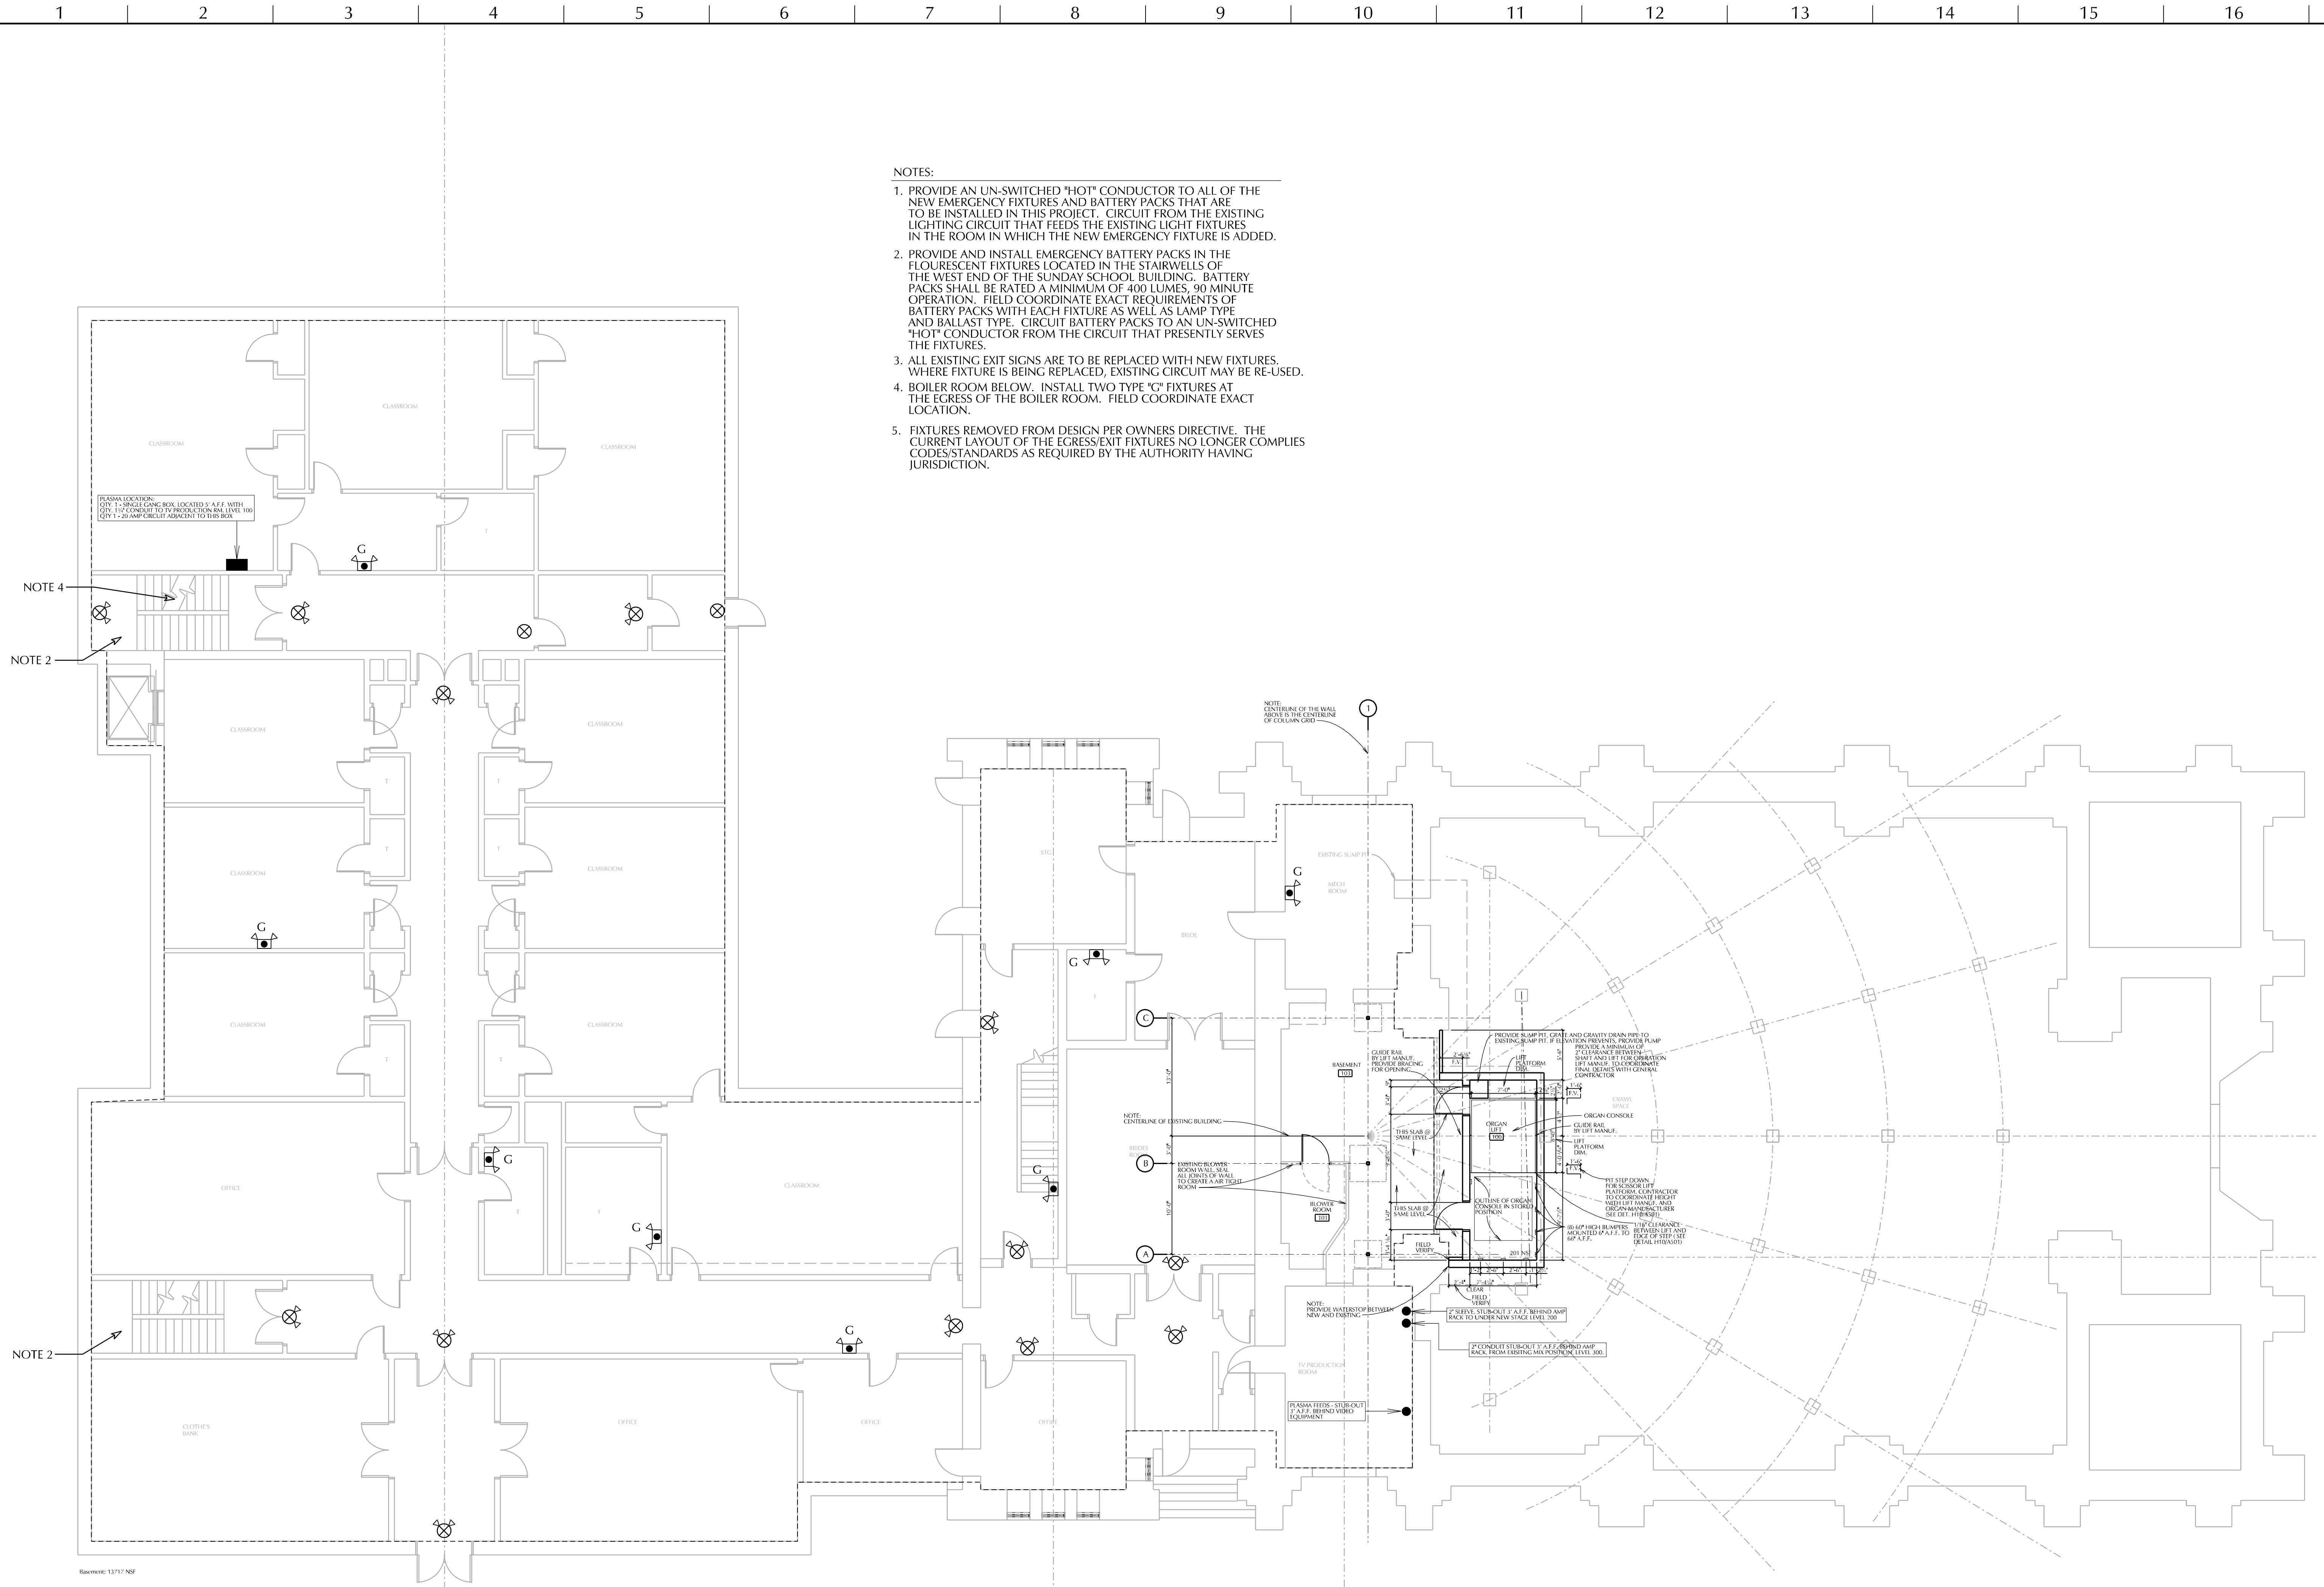

NOTES:

1. PROVIDE AN UN-SWITCHED "HOT" CONDUCTOR TO ALL OF THE NEW EMERGENCY FIXTURES AND BATTERY PACKS THAT ARE TO BE INSTALLED IN THIS PROJECT. CIRCUIT FROM THE EXISTING LIGHTING CIRCUIT THAT FEEDS THE EXISTING LIGHT FIXTURES IN THE ROOM IN WHICH THE NEW EMERGENCY FIXTURE IS ADDED.
2. PROVIDE AND INSTALL EMERGENCY BATTERY PACKS IN THE FLOURESCENT FIXTURES LOCATED IN THE STAIRWELLS OF THE WEST END OF THE SUNDAY SCHOOL BUILDING. BATTERY PACKS SHALL BE RATED A MINIMUM OF 400 LUMES, 90 MINUTE OPERATION. FIELD COORDINATE EXACT REPLY FIXTURES AND BATTERY PACKS WITH EACH FIXTURE AS WELL AS LAMP TYPE AND BALLAST TYPE. CIRCUIT BATTERY PACKS TO AN UN-SWITCHED "HOT" CONDUCTOR FROM THE CIRCUIT THAT PRESENTLY SERVES THE EXISTING FIXTURES.
3. ALL EXISTING EXIT SIGNS ARE TO BE REPLACED WITH NEW FIXTURES, WHERE FIXTURE IS BEING REPLACED, EXISTING CIRCUIT MAY BE RE-USED.
4. BOILER ROOM BELOW. INSTALL TWO TYPE "C" FIXTURES AT THE EGRESS OF THE BOILER ROOM. FIELD COORDINATE EXACT LOCATION.
5. FIXTURES REMOVED FROM DESIGN PER OWNERS DIRECTIVE. THE CURRENT LAYOUT OF THE EGRESS EXISTING FIXTURES NO LONGER COMPLIES WITH CURRENT STANDARDS AS REQUIRED BY THE AUTHORITY HAVING JURISDICTION.

## KEY PLAN

SHEET TITLE  
LEVEL 100 LIGHTING PLAN



INTERIOR RENOVATION FOR  
**ATLANTA FIRST  
UNITED METHODIST CHURCH**  
360 PEACHTREE ST NE ATLANTA, GA 30308


10/04/2007
'AS BUILT' DRAWINGS

PROJECT NO:  
● 2005-0018

CAD FILE NAME:  
● ...\\5018e113.dgn

COPYRIGHT © 2004 by CDH PARTNERS INC.  
All rights reserved. These documents,  
as instruments of service, remain the  
property of the architect and no part  
may be used or reproduced without  
prior written permission of the  
copyright owner.

DRAWING NUMBER  
**E113**  
OF

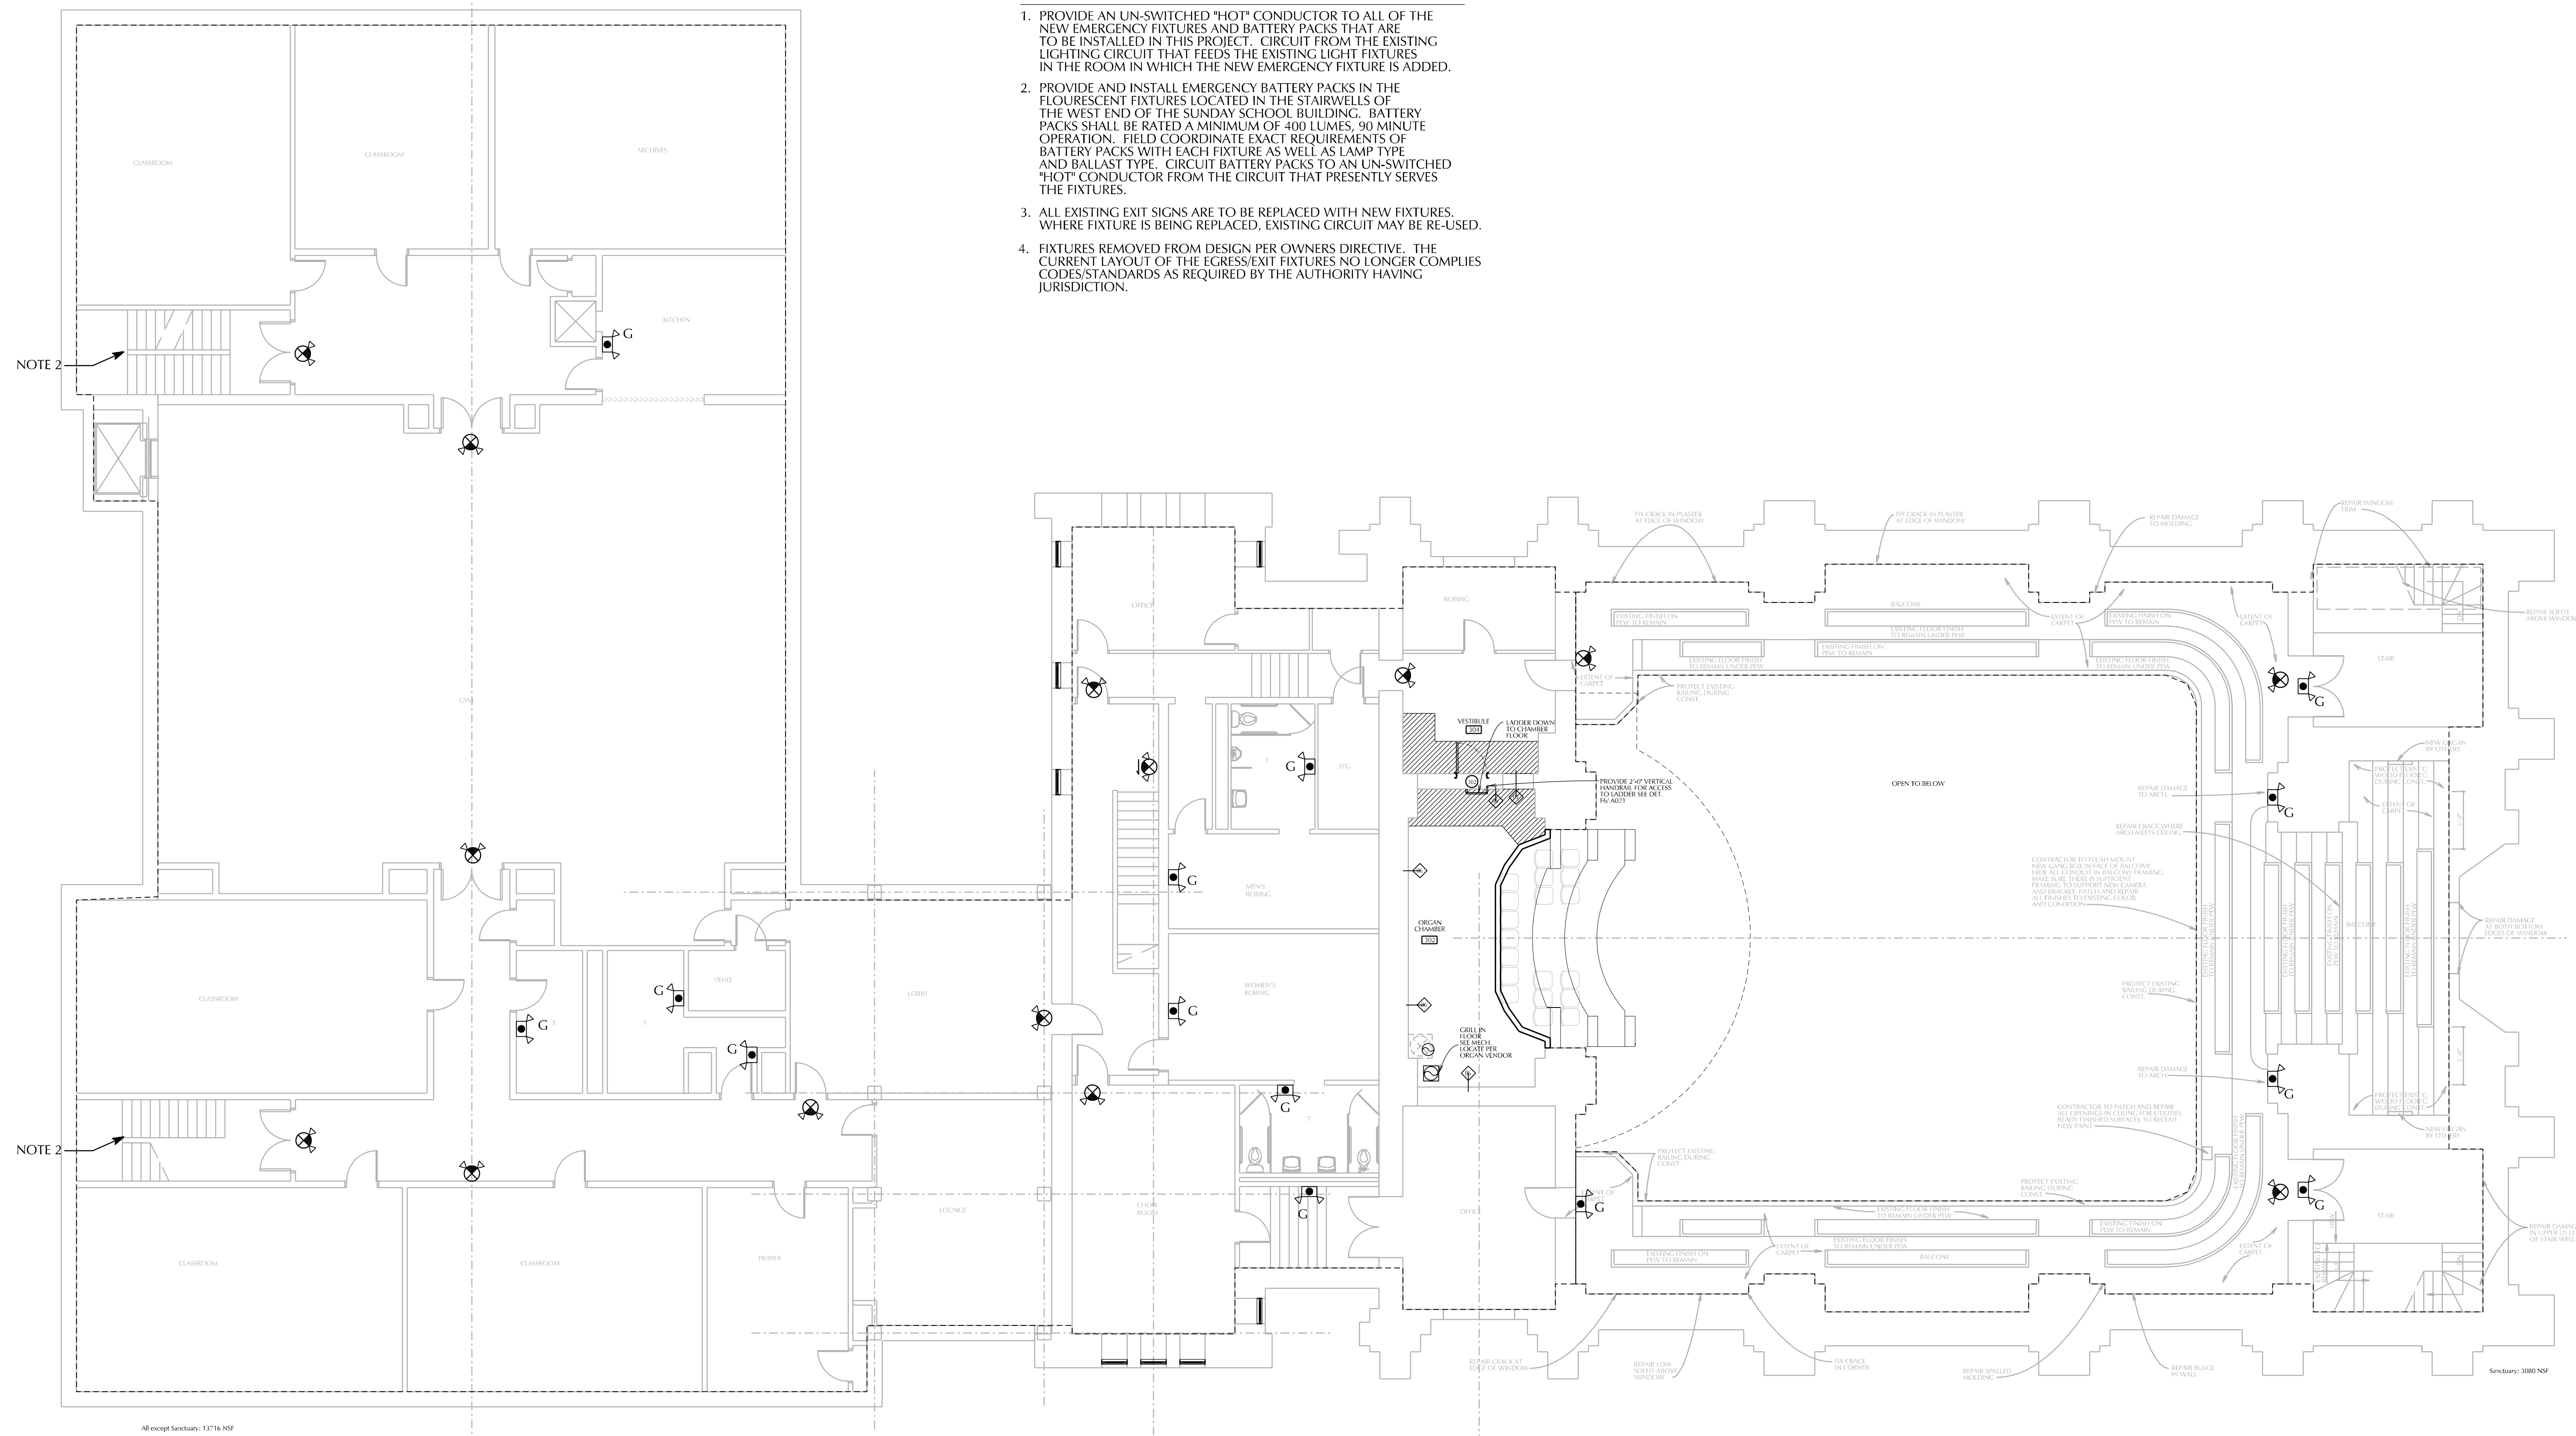

NOTES:

1. PROVIDE AN UN-SWITCHED "HOT" CONDUCTOR TO ALL OF THE NEW EMERGENCY FIXTURES AND BATTERY PACKS THAT ARE TO BE INSTALLED IN THIS PROJECT. CIRCUIT FROM THE EXISTING EMERGENCY CIRCUIT TO THE NEW EMERGENCY FIXTURES IN THE ROOM IN WHICH THE NEW EMERGENCY FIXTURE IS ADDED.
2. PROVIDE AND INSTALL EMERGENCY BATTERY PACKS IN THE FLOURESCENT FIXTURES LOCATED IN THE STAIRWELLS OF THE WEST END OF THE SUNDAY SCHOOL BUILDING. BATTERY PACKS SHALL BE OF THE MINIMUM VOLTAGE AND 90 MINUTE OPERATION. FIELD COORDINATE EXACT REQUIREMENTS OF BATTERY PACKS WITH EACH FIXTURE AS WELL AS LAMP TYPE AND LAMP TYPE. CIRCUIT BY THE FIXTURES TO AN UN-SWITCHED "HOT" CONDUCTOR FROM THE CIRCUIT THAT PRESENTLY SERVES THE FIXTURES.
3. ALL EXISTING EIT SIGNS ARE TO BE REPLACED WITH NEW FIXTURES, WHERE FIXTURE IS BEING REPLACED, EXISTING CIRCUIT MAY BE RE-USED.
4. FIXTURES REMOVED FROM DESIGN PER OWNER'S DIRECTIVE. THE CURRENT LANDLORDS OF THE EGRESS/EIT FIXTURES NO LONGER COMPLY WITH STANDARDS AS REQUIRED BY THE AUTHORITY HAVING JURISDICTION.

NOTE 2-

NOTE 2-

Secondary: 1000 NS

**KEY PLAN**

SHEET TITLE  
LEVEL 300 LIGHTING PLAN

A1	LEVEL 300 LIGHTING PLAN
----	-------------------------

$1/8^{\text{H}} = 1'-0^{\text{H}}$	E003	XP003-5018.DGN
------------------------------------	------	----------------



Date: Tuesday, December 11, 2007

Copies To: File

To: Wally Colly  
 Atlanta FUMC  
 360 Peachtree St Ne  
 Atlanta, GA 30308-3235  
 (404) 524-6614 FAX: (404) 521-3709  
 w.colly@comcast.net

By: Ken Bass  
 Re: Atlanta First UMC-chancel renovation

Direct: 678.784.3411  
 Project #: 2005-0018

**Transmitted Herewith:**

- |  |   |   |
|--|---|---|
| <input type="checkbox"/> Shop Drawings       | <input type="checkbox"/> Copy Of Letter   | <input type="checkbox"/> Invoice            |
| <input type="checkbox"/> Specifications      | <input type="checkbox"/> Change Order     | <input type="checkbox"/> Pay Request        |
| <input checked="" type="checkbox"/> Drawings | <input type="checkbox"/> Contract         | <input type="checkbox"/> Product Literature |
| <input type="checkbox"/> Report              | <input type="checkbox"/> Electronic Files | <input type="checkbox"/> _____              |

**Disposition:**

- |  |  |  |
|--|--|--|
| <input type="checkbox"/> For Approval        | <input type="checkbox"/> For Signature           | <input type="checkbox"/> For Payment           |
| <input type="checkbox"/> No Exceptions Taken | <input checked="" type="checkbox"/> For Your Use | <input type="checkbox"/> As You Requested      |
| <input type="checkbox"/> Exceptions Noted    | <input type="checkbox"/> For Review And Comment  | <input type="checkbox"/> Per Transmitted Items |
| <input type="checkbox"/> Resubmit            | <input type="checkbox"/> _____                   |  |

COPIES	IDENTIFICATION	DESCRIPTION
3		As Built Drawings-full size
1		Disc containing all drawings files.

**REMARKS:**

- |  |                        |
|--|------------------------|
| <input type="checkbox"/> FAX: _____<br><input type="checkbox"/> E-MAIL: _____<br><input type="checkbox"/> MAIL<br><input checked="" type="checkbox"/> COURIER<br><input type="checkbox"/> HAND DELIVERED | PAGES TO FOLLOW: _____ |
|--|------------------------|